

Prentiss
 L 2004
 6-28-68

MISSISSIPPI
 BOARD OF WATER COMMISSIONERS
 416 North State Street
 Jackson, Mississippi 39201

WATER WELL DRILLERS LOG

June 28 1968 Bonds Prentiss
 date well completed firm name county well located


LANDOWNER: Baltes Cunningham
 Rt. 4
 Booneville, Miss.
 (mailing address)

description of formations encountered	from to	
	feet	feet
Sandy Clay	0	5
Red Sand	5	13
White "	13	20
Blue Clay (Sandy)	20	130
Water Sand	130	195

WELL LOCATION:
 sec. 7 T. 6 N. R. 8 E.
 S. W.
5 3/4 miles 3 E of Booneville
 (distance) (direction) (nearest town)

WELL PURPOSE: Home
 (home, irrigation, municipal, industrial)


- WELL COMPLETION DATA:
- (1) diameter (inches) 4
 - (2) total depth (feet) 195
 - (3) static water level (feet) 165 below top of ground.
 - (4) casing Steel, 21 (material) (depth)
~~4~~ " if telescope see back. (size)
 - (5) screen none (length) (depth to top)
none (size) (material)
 - (6) pump installed sun pump (HP) (yield gpm)
Elect (type power)
 - (7) electric log no (yes or no)
none (organization running log)
 - (8) how well bottom plugged open

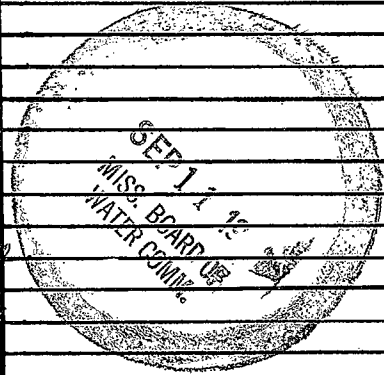

DRILLERS REMARKS:

If well telescopes please sketch and show depths.

GROUND LEVEL

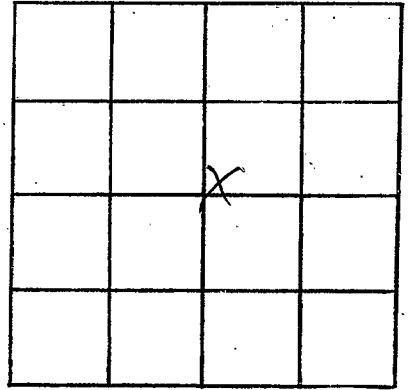

SECTION 7

Please indicate well location X.

ADDITIONAL INFORMATION

If more than one screen,
show locations of each on sketch.