

PRENTISS

L 2005

12-5-75

MISSISSIPPI BOARD OF WATER COMMISSIONERS 416 North State Street Jackson, Mississippi 39201

WATER WELL DRILLERS LOG

12-5-1975 Bonds Well Drilling Prentiss date well completed firm name county well located

LANDOWNER: Billy Arnold

Boneville

(mailing address)

WELL LOCATION:

sec 6 T 6 N R 8 E S 3 W

3 miles SE of Boneville (distance) (direction) (nearest town)

WELL PURPOSE: Home (home, irrigation, municipal, industrial)

WELL COMPLETION DATA:

- (1) diameter (inches) 4"
(2) total depth (feet) 258'
(3) static water level (feet) 150 below top of ground
(4) casing Plastic, 60' (material) (depth)

(size) if telescope see back.

- (5) screen no (length) (depth to top)

(size) (material)

- (6) pump 1 1/2 (HP) 5000 (yield gpm)

elect. (type power)

- (7) electric log no (yes or no)

(organization running log)

- (8) how well bottom plugged open

description of formations encountered

from

to

Table with 3 columns: description of formations encountered, from, to. Rows include Red Clay (0-15), Yellow Sand (15-50), Blue Clay (50-210), and Water Sand (210-258).


DRILLERS REMARKS:

RECEIVED DEC - 7 1978

MISS. BD. OF WATER COMMISSIONERS

If well telescopes please sketch and show depths.

GROUND LEVEL

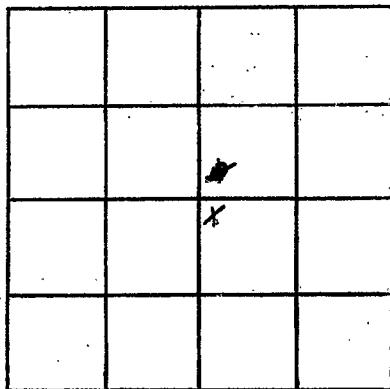

SECTION _____

Please indicate well location X.

ADDITIONAL INFORMATION

If more than one screen,
show locations of each on sketch.