

PRENTISS
L <i>Joce</i>
8-2-76

**MISSISSIPPI
BOARD OF WATER COMMISSIONERS**
416 North State Street
Jackson, Mississippi 39201

WATER WELL DRILLERS LOG

8-2 1976 *BombWell Drilling* *Prentiss*
 date well completed firm name county well located

LANDOWNER: <i>Mike Garvin</i> <i>Boneville</i> (mailing address)	description of formations encountered	from	to
	<i>Red Clay</i>	<i>0</i>	<i>20</i>
	<i>Yellow Sand</i>	<i>20</i>	<i>25</i>
	<i>Blue Clay</i>	<i>25</i>	<i>200</i>
	<i>Water Sand</i>	<i>200</i>	<i>258</i>

WELL LOCATION:
 sect *12* T *6* N R *8* E
 7 miles S of *Boneville*
 (distance) (direction) (nearest town)

WELL PURPOSE:
 (home, irrigation, municipal, industrial)

WELL COMPLETION DATA:

(1) diameter (inches) *4"*

(2) total depth (feet) *258'*

(3) static water level (feet) *50* ^{below} _{above} top of ground.

(4) casing *Plastic* *40'*
 (material) (depth)
 (size) if telescope see back.

(5) screen *no*
 (length) (depth to top)
 (size) (material)

(6) pump *1 1/2* *5 gpm*
 (HP) (yield gpm)
oil
 (type power)

(7) electric log *no*
 (yes or no)
 (organization running log)

(8) how well bottom plugged *open*


DRILLERS REMARKS:

RECEIVED
DEC-7 1976

MISS. BD. OF WATER COMMISSIONERS

If well telescopes please sketch and show depths.

GROUND LEVEL

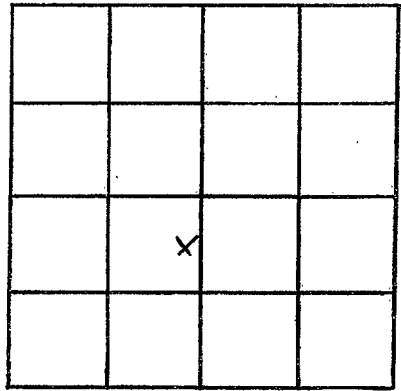

SECTION _____

Please indicate well location X.

ADDITIONAL INFORMATION

If more than one screen,
show locations of each on sketch.