

PRENTISS
L <u>2007</u>
11-15-76

**MISSISSIPPI
BOARD OF WATER COMMISSIONERS**
416 North State Street
Jackson, Mississippi 39201

WATER WELL DRILLERS LOG

11-15 1976 Bonds Well Drilling Prentiss
 date well completed firm name county well located

LANDOWNER: <u>George Pharr</u> <u>New Site</u>	description of formations encountered	from	to
		0	20
(mailing address)	<u>Red Clay</u>	20	60
	<u>Yellow Sand</u>	60	120
	<u>Water Sand</u>		

WELL LOCATION:
 sec. 13 T. 7 N R. 8 E
6 miles S of New Site
 (distance) (direction) (nearest town)

WELL PURPOSE: Home
 (home, irrigation, municipal, industrial)

WELL COMPLETION DATA:

(1) diameter (inches) 4"

(2) total depth (feet) 120'

(3) static water level (feet) 50 below above top of ground.

(4) casing Plastic, 120'
 (material) (depth)
 (size) If telescope see back.

(5) screen 120' Perforated
 (length) (depth to top)
 (size) (material)

(6) pump 3/4 10 gpm
 (HP) (yield gpm)
elect
 (type power)

(7) electric log no
 (yes or no)
 (organization running log)


(8) how well bottom plugged plugged

DRILLERS REMARKS:

RECEIVED
 DEC - 7 1976
 MISS. BD. OF WATER COM.

If well telescopes please sketch and show depths.

GROUND LEVEL

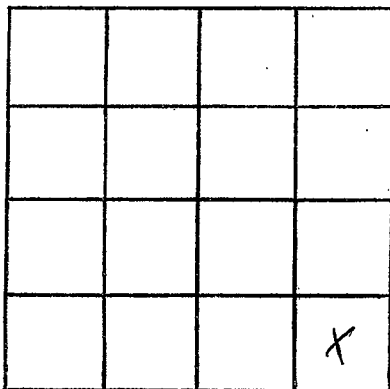

SECTION _____

Please indicate well location X.

ADDITIONAL INFORMATION

If more than one screen,
show locations of each on sketch.