

PRENTISS

L 205A

3-18-77

MISSISSIPPI
BOARD OF WATER COMMISSIONERS
416 North State Street
Jackson, Mississippi 39201

WATER WELL DRILLERS LOG

3-18 1977 Bonds Well Drilling Prentiss
date well completed firm name county well located

LANDOWNER: Jimmy Garvin

Booneville

(mailing address)

description of formations encountered

from

to

Red Clay

0 20

Yellow Sand

20 35

Blue Clay

35 220

Water Sand

220 280

WELL LOCATION:

sec 12 T 6 N R 8 E

7 miles S of Booneville
(distance) (direction) (nearest town)

WELL PURPOSE: Home
(home, irrigation, municipal, industrial)

WELL COMPLETION DATA:

- (1) diameter (inches) 4"
- (2) total depth (feet) 280'
- (3) static water level (feet) 50 below above top of ground.
- (4) casing Plastic 42'
(material) (depth)

(size) if telescope see back.

- (5) screen no
(length) (depth to top)

(size) (material)

- (6) pump 3/4 10 gpm
(HP) (yield gpm)


elect
(type power)

- (7) electric log no
(yes or no)

(organization running log)

- (8) how well bottom plugged open


DRILLERS REMARKS:

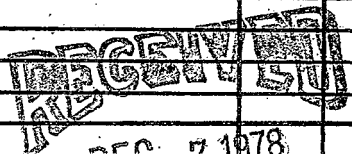

MISS. BD. OF WATER COMM

If well telescopes please sketch and show depths.

GROUND LEVEL

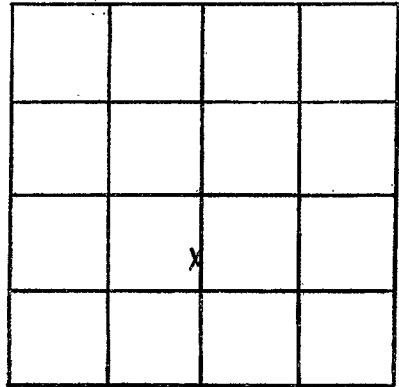

SECTION _____

Please indicate well location X.

ADDITIONAL INFORMATION

If more than one screen, show locations of each on sketch.