

PRENTISS

L 2010

4-12-77

MISSISSIPPI BOARD OF WATER COMMISSIONERS 416 North State Street Jackson, Mississippi 39201

WATER WELL DRILLERS LOG

4-12 1977 Bonds Well Drilling Prentiss date well completed firm name county well located

Table with columns for well location, purpose, completion data, and descriptions of formations encountered (Red Clay, Yellow Sand, Blue Clay, Water Sand) with depth measurements from 0 to 175 feet.

LANDOWNER: Milton Pless

New Site

description of formations encountered

from to

Red Clay 0 20
Yellow Sand 20 40
Blue Clay 40 105
Water Sand 105 175

(mailing address)

WELL LOCATION:

sec. 19 T. 6 N R. 8 E S W
5 miles N of Marietta
(distance) (direction) (nearest town)

WELL PURPOSE: Home
(home, irrigation, municipal, industrial)

WELL COMPLETION DATA:

- (1) diameter (inches) 4"
(2) total depth (feet) 175'
(3) static water level (feet) 50 below top of ground.
(4) casing Plastic 45' (material) (depth)
(size) If telescope see back.
(5) screen no (length) (depth to top)
(size) (material)
(6) pump 3/4 10 gpm (HP) (yield gpm)
elect (type power)
(7) electric log no (yes or no)
(organization running log)
(8) how well bottom plugged open


RECEIVED
DEC - 7 1978

MISS. BD. OF WATER COMMISSIONERS

DRILLERS REMARKS:

If well telescopes please sketch and show depths.

GROUND LEVEL

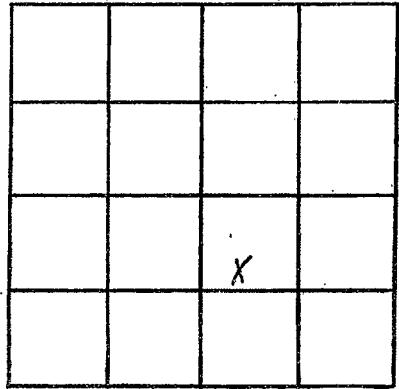

SECTION \_\_\_\_\_

Please indicate well location X.

ADDITIONAL INFORMATION

If more than one screen,  
show locations of each on sketch.