

Prentiss
 L 200
 4-22-77

MISSISSIPPI
 BOARD OF WATER COMMISSIONERS
 416 North State Street
 Jackson, Mississippi 39201

138

WATER WELL DRILLERS LOG

4-22-77 date well completed
 77 Herman Homan Well & Supply, Inc.
 P. O. Box 42
 firm name
 SHANNON, MISSISSIPPI 38868
 Prentiss county well located

LANDOWNER:
 John Hamilton
 33 Baldwyn, MS
 (mailing address)

description of formations encountered	from	to
surface sands	0	40
blue clay	40	140
sand	140	280
bottom	280	

WELL LOCATION:
 sec. 17 T. 6 N. R. 8 E
 S W
 3 1/2 miles NW of Marietta
 (distance) (direction) (nearest town)

WELL PURPOSE:
 Home
 (home, irrigation, municipal, industrial)

- WELL COMPLETION DATA:
- (1) diameter (inches) 4"
 - (2) total depth (feet) 280'
 - (3) static water level (feet) 132' below top of ground.
 - (4) casing (material) steel, (depth) 251'
 4" (size) if telescope see back.
 - (5) screen (length) ND, (depth to top) ND
 (size) (material)
 - (6) pump 1/2 (HP), 45 (yield gpm)
 electric (type power)
 - (7) electric log NO (yes or no)
 (organization running log)
 - (8) how well bottom plugged open


RECEIVED
 JUN 1 1977

DRILLERS REMARKS:

MISS. BD. OF WATER COMM

If well telescopes please sketch and show depths.

GROUND LEVEL

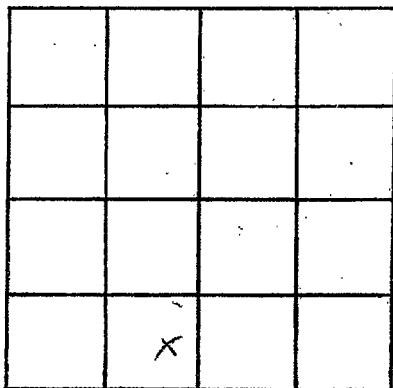

SECTION 19

Please indicate well location X.

ADDITIONAL INFORMATION

If more than one screen, show locations of each on sketch.