

PRENTISS  
L 2013  
3/10/78

MISSISSIPPI  
BOARD OF WATER COMMISSIONERS  
416 North State Street  
Jackson, Mississippi 39201

WATER WELL DRILLERS LOG

Herman Homan Well & Supply, Inc.

P. O. Box 42

SHANNON, MISSISSIPPI 39368

Prentiss  
county well located

3-10 1978  
date well completed

LANDOWNER:

Charles Badas  
Rt 3 Baldwin, Ms  
(mailing address)

description of formations encountered

from to

Surface sand 0 16  
+ clay 16 140  
Black clay 140 280  
Sand 280 280  
Bentonite 280

WELL LOCATION:

sec. 19 T. 6 N. R. 3 E  
3 1/2 miles NE of Maricopa  
(distance) (direction) (nearest town)

WELL PURPOSE:

Home  
(home, irrigation, municipal, industrial)

WELL COMPLETION DATA:

- (1) diameter (inches) 4"
- (2) total depth (feet) 280'
- (3) static water level (feet) 140' below top of ground
- (4) casing Steel 2" (material), 20' (depth)  
4" (size) if telescope see back.
- (5) screen 20' (length), (depth to top)  
(size) (material)
- (6) pump 1/2 (HP), 5 (yield gpm)  
electric (type power)
- (7) electric log 20 (yes or no)

(organization running log)

- (8) how well bottom plugged open


DRILLERS REMARKS:

RECEIVED

MAR 23 1978

If well telescopes please  
sketch and show depths.

GROUND LEVEL

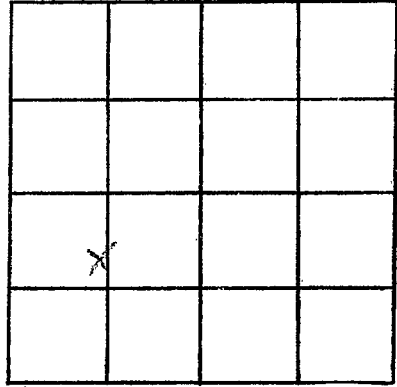

SECTION 19

Please indicate well location X.

ADDITIONAL INFORMATION

If more than one screen,  
show locations of each on sketch.