

PRENTISS

L 2014

10-13-78

MISSISSIPPI BOARD OF WATER COMMISSIONERS  
416 North State Street  
Jackson, Mississippi 39201

WATER WELL DRILLERS LOG


10-13-1978 Bond Well Drilling Prentiss  
date well completed firm name county well located

LANDOWNER: <u>Donald Gann</u>	description of formations encountered	from	to
<u>Booneville</u>	<u>Red Clay</u>	0	10
	<u>Yellow Sand</u>	10	35
(mailing address)	<u>Blue Clay</u>	35	150
WELL LOCATION:	<u>Water Seal</u>	150	210
sec. <u>12</u> T. <u>6</u> N. R. <u>3</u> E.			
<u>77</u> miles <u>S 7</u> of <u>Booneville</u>			
(distance) (direction) (nearest town)			
WELL PURPOSE: <u>None</u> (home, irrigation, municipal, industrial)			
WELL COMPLETION DATA:			
(1) diameter (inches) <u>4"</u>			
(2) total depth (feet) <u>210'</u>			
(3) static water level (feet) <u>60</u> <u>below</u> above top of ground.			
(4) casing <u>Plastic</u> , <u>42'</u> (material) (depth)			
(size) if telescope see back.			
(5) screen <u>no</u> (length) (depth to top)			
(size) (material)			
(6) pump <u>1 1/2</u> <u>5 gpm</u> (HP) (yield gpm)			
<u>elect</u> (type power)			
(7) electric log <u>no</u> (yes or no)			
(organization running log)			
(8) how well bottom plugged <u>open</u>			
DRILLERS REMARKS:			

RECEIVED  
DEC - 5 1978  
MISS. Bd. OF WATER COMMISSIONERS

If well telescopes please sketch and show depths.

GROUND LEVEL

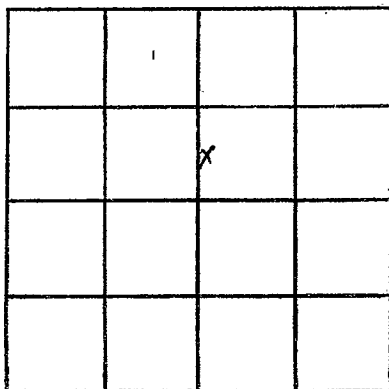

SECTION \_\_\_\_\_

Please indicate well location X.

ADDITIONAL INFORMATION

If more than one screen,  
show locations of each on sketch.