

PRENTISS

L 2015

9-13-78

MISSISSIPPI BOARD OF WATER COMMISSIONERS
416 North State Street
Jackson, Mississippi 39201

WATER WELL DRILLERS LOG

9-13 1978 Bonds Well Drilling Prentiss
date well completed firm name county well located

LANDOWNER: Russel Burdette

Bonnaville

(mailing address)

description of formations encountered

from

to

Red Clay

0

10

Yellow Sand

10

15

Blue Clay

15

240

Water Sand

240

300

WELL LOCATION:

sec 29 T 6 N R 8 E
3 miles N of Marietta
(distance) (direction) (nearest town)

WELL PURPOSE: Home
(home, irrigation, municipal, industrial)

WELL COMPLETION DATA:

- (1) diameter (inches) 4"
- (2) total depth (feet) 300'
- (3) static water level (feet) 90' ^{below} top of ground.
- (4) casing Plastic, 20' (material) (depth)

(size) If telescope see back.

- (5) screen no (length) (depth to top)

(size) (material)

- (6) pump 1 (HP) 5 gpm (yield gpm)

elect (type power)

- (7) electric log no (yes or no)

(organization running log)

- (8) how well bottom plugged open


DRILLERS REMARKS:

RECEIVED
DEC-5-1978

MISS. BD. OF WATER COMMISSIONERS

If well telescopes please sketch and show depths.

GROUND LEVEL

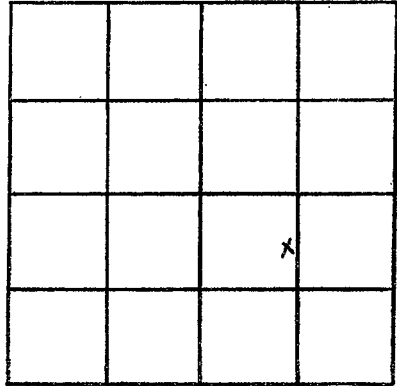

SECTION _____

Please indicate well location X.

ADDITIONAL INFORMATION

If more than one screen, show locations of each on sketch.