

PRENTISS

L 2016

5-18-78

MISSISSIPPI BOARD OF WATER COMMISSIONERS
416 North State Street
Jackson, Mississippi 39201

WATER WELL DRILLERS LOG

5-18 1978 Bonds Well Drilling Prentiss
date well completed firm name county well located

LANDOWNER: Enlas Isbelle

description of formations encountered

from to

Red Clay	0	10
Yellow Sand	10	15
Blue Clay	15	110
Water Sand	110	172

(mailing address)

WELL LOCATION:

sec 36 T 6 N R 2 E
2 miles S of New Site
(distance) (direction) (nearest town)

WELL PURPOSE: Home
(home, irrigation, municipal, industrial)

WELL COMPLETION DATA:

- (1) diameter (inches) 4"
- (2) total depth (feet) 172'
- (3) static water level (feet) 50 below top of ground.
- (4) casing Plastics, 21
(material) (depth)
(size) if telescope see back.
- (5) screen no
(length) (depth to top)
(size) (material)
- (6) pump 3/4 10 gpm
(HP) (yield gpm)
elect
(type power)
- (7) electric log no
(yes or no)
(organization running log)
- (8) how well bottom plugged open


DRILLERS REMARKS:

RECEIVED
DEC - 5 1978

MISS. BD. OF WATER COMM

If well telescopes please sketch and show depths.

GROUND LEVEL

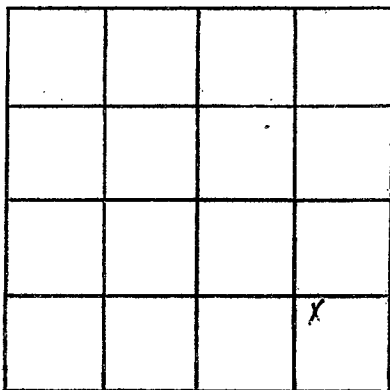

SECTION _____

Please indicate well location X.

ADDITIONAL INFORMATION

If more than one screen,
show locations of each on sketch.