

PRENTISS  
 L 2007  
 4-18-79

MISSISSIPPI  
 BOARD OF WATER COMMISSIONERS  
 416 North State Street  
 Jackson, Mississippi 39201

WATER WELL DRILLERS LOG

4-18 1979 Bonds Well Drilling Prentiss  
 date well completed firm name county well located

LANDOWNER Carlton B. Barnes  
Marietta  
 (mailing address)

description of formations encountered	from	to
	Red Clay	0
Blue Clay	38	210
Water Sand	210	279 1/2

WELL LOCATION:  
 sect 9 T 6 N R 8 E  
3 miles N of Marietta  
 (distance) (direction) (nearest town)

WELL PURPOSE: Home  
 (home, irrigation, municipal, industrial)

- WELL COMPLETION DATA:
- (1) diameter (inches) 4"
  - (2) total depth (feet) 279 1/2'
  - (3) static water level (feet) 50 <sup>below</sup> <sub>above</sub> top of ground.
  - (4) casing Plastic, 40'  
 (material) (depth)  
 \_\_\_\_\_ If telescope see back.  
 (size)
  - (5) screen \_\_\_\_\_  
 (length) (depth to top)  
 (size) (material)
  - (6) pump 3/4 10  
 (HP) (yield gpm)  
submersible  
 (type power)
  - (7) electric log no  
 (yes or no)  
 \_\_\_\_\_  
 (organization running log)
  - (8) how well bottom plugged open

DRILLERS REMARKS:


Miss. Board of Water Comm.

JUN - 8 1979

RECEIVED

If well telescopes please sketch and show depths.

GROUND LEVEL

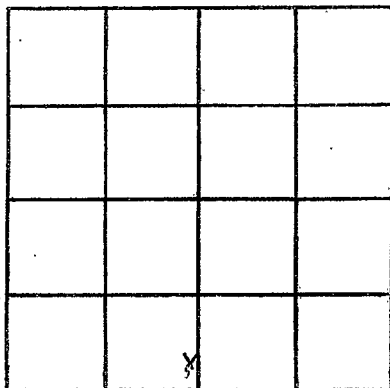

SECTION \_\_\_\_\_

Please indicate well location X.

ADDITIONAL INFORMATION

If more than one screen, show locations of each on sketch.