

PRENTISS

L 2018

4-21-79

MISSISSIPPI  
BOARD OF WATER COMMISSIONERS  
416 North State Street  
Jackson, Mississippi 39201

WATER WELL DRILLERS LOG

4-21 date well completed

1979 Bonds Well Drilling firm name

Prentiss county well located

LANDOWNER: Ronnie Breedlove

Booneville

(mailing address)

description of formations encountered

from

to

Red Clay	0	38
Blue Clay	38	170
Water seal	170	236

WELL LOCATION:

sec. 7 T. 6 N R. 9 E

5 miles SE of Booneville  
(distance) (direction) (nearest town)

WELL PURPOSE: None  
(home, irrigation, municipal, industrial)

WELL COMPLETION DATA:

(1) diameter (inches) 4"

(2) total depth (feet) 236

(3) static water level (feet) 70 below above top of ground.

(4) casing Plastic, 40  
(material) (depth)

(size) if telescope see back.

(5) screen \_\_\_\_\_  
(length) (depth to top)

(size) (material)

(6) pump 3/4 10  
(HP) (yield gpm)

submersible  
(type power)

(7) electric log no  
(yes or no)

(organization running log)

(8) how well bottom plugged open

DRILLERS REMARKS:


Miss. Board of Water Comm.

JUN - 6 1979

RECEIVED

If well telescopes please sketch and show depths.

GROUND LEVEL

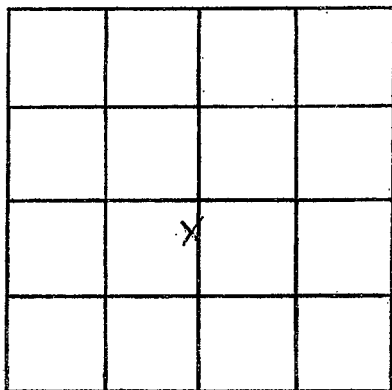

SECTION \_\_\_\_\_

Please indicate well location X.

ADDITIONAL INFORMATION

If more than one screen, show locations of each on sketch.