

PRENTISS
L 2020
10/7/80

MISSISSIPPI
 BOARD OF WATER COMMISSIONERS
 416 North State Street
 Jackson, Mississippi 39201

WATER WELL DRILLERS LOG

10-7-80 19 Bonds Well Drilling Prentiss
 date well completed firm name county well located

LANDOWNER Jallis Roberts
Baldwyn, MS.
 (mailing address)

description of formations encountered
 from to
0-36 Red clay
36-112 Blue clay
112-151 Water sand

WELL LOCATION:
 sec. 28 T-7 N 6 R-8 E
7 miles E of Baldwyn
 (distance) (direction) (nearest town)

WELL PURPOSE: Home
 (home, irrigation, municipal, industrial)

- WELL COMPLETION DATA:
- (1) diameter (inches) 4"
 - (2) total depth (feet) 151
 - (3) static water level (feet) 25 below above top of ground.
 - (4) casing Plastic, 40,
 (material) (depth)
 (size) If telescope see back.
 - (5) screen _____
 (length) (depth to top)
 (size) (material)
 - (6) pump 3/4 1000/min.
 (HP) (yield gpm)
Elec.
 (type power)
 - (7) electric log no
 (yes or no)
 (organization running log)
 - (8) how well bottom plugged open

DRILLERS REMARKS:


DEPT. OF NATURAL RESOURCES
 BUREAU OF LAND & WATER RESOURCES

MAY 19 1981

RECEIVED

If well telescopes please sketch and show depths.

GROUND LEVEL

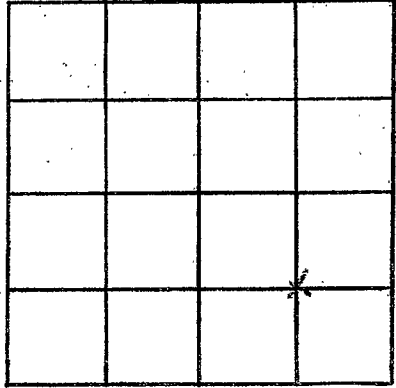

SECTION _____

Please indicate well location X.

ADDITIONAL INFORMATION

If more than one screen, show locations of each on sketch.