

**MISSISSIPPI DEPARTMENT OF ENVIRONMENTAL QUALITY**  
Bureau of Land and Water Resources

P. O. Box 10631  
Jackson, MS 39289-0631  
**WATER WELL DRILLERS LOG**

COUNTY WELL LOCATED <b>TRENTISS</b>	
WELL NUMBER <b>L2001</b>	CODED
DATE WELL COMPLETED <b>11/15/95</b>	

PERMIT NUMBER
NAME OF DRILLING FIRM <b>Hendon Well &amp; Supply</b>
<b>Shannon MS</b>

NAME & MAILING ADDRESS OF LANDOWNER <b>J. W. Green</b>			
<b>Rt 1, Box 251</b>			
<b>Marietta, MS 38856</b>			
WELL LOCATION:	SEC	TOWNSHIP	RANGE
	<b>17</b>	<b>7</b>	<b>8</b> <input checked="" type="checkbox"/> E <input checked="" type="checkbox"/> S
DISTANCE	DIRECTION	NEAREST TOWN	
<b>1 1/2</b> Miles	<b>S</b>	of <b>Marietta</b>	
OTHER LANDMARK			
WELL PURPOSE (Home, Irrigation, Municipal, Industrial, Fish Pond, etc.)			

<b>PUMP DATA</b>		
PUMP TYPE (Circle One): <input checked="" type="checkbox"/> Submersible, Turbine, Jet, Flowing Well, Other (Describe) _____		
POWER TYPE (Circle One): <input checked="" type="checkbox"/> Electric, Tractor, Diesel, Gasoline, Butane, Other (Describe) _____ H/P <b>1/2</b>		
Pump Capacity (GPM)	No. of Stages	Setting Depth
<b>7</b>	<b>11</b>	<b>84'</b> FT.
PUMP TEST		
Well yielded _____ GPM with a drawdown of _____ ft. after _____ hours of pumping		

<b>WELL DATA</b>		
Well Depth <b>110'</b>	Casing Diameter (In.) <b>4"</b>	Casing Length (Ft.) <b>97'</b>
Type of Casing <b>PVC</b>	Hole Depth <b>110'</b>	Depth to Static Water Level <b>45'</b>
TYPE OF COMPLETION: (Circle One or More): <input checked="" type="checkbox"/> Gravel Packed, Underreamed, Telescoped, Natural Development, Open Hole, Other (Describe) _____		
Top of Lap Pipe or Reduction in Casing		
FEET <input type="checkbox"/> IF TELESCOPED OR MORE THAN ONE SCREEN: USE BACK PAGE		

<b>LOG DATA</b>	
TYPE OF LOG RUN (Circle One): Electric, Gamma Ray, Density, Sonic, Neutron, Other (Describe) _____ <input checked="" type="checkbox"/> No Log Run	
Name of Organization Running Log	

<b>SCREEN DATA</b>		
Diameter - Inches <b>4"</b>	Length - Feet <b>10'</b>	Slot Size - Inches
Screen Type <b>PVC</b>	Depth to Bottom - Feet <b>110'</b>	


<b>GEOLOGIC DATA (Office Use Only)</b>			
Surface Elev.	Geologic Unit	Unit Thickness	Depth to Top
Subs. SWL	Date	Analysis	Aquifer Test
Driller's Remarks			

DESCRIPTION OF FORMATIONS ENCOUNTERED	FROM	TO
Red Clay	0	10
Red Sand	10	20
White Clay	20	45
Blue Clay + Sand	45	60
Sand + lignite	60	110

FORMATIONS (Continued) FROM _____ TO _____	
<b>RECEIVED</b>	
<b>NOV 21 1995</b>	
Dept. of Environmental Quality Office of Land & Water Resources	
IF MORE SPACE IS NEEDED, USE BACK	

If well telescopes please  
sketch and show depths.

GROUND LEVEL

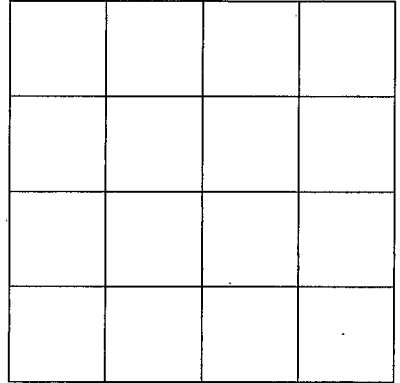

SECTION \_\_\_\_\_

Please indicate well location X.

ADDITIONAL INFORMATION

If more than one screen,  
show location of each on sketch.