

Prentiss
M 10
9-10-71

MISSISSIPPI
BOARD OF WATER COMMISSIONERS
416 North State Street
Jackson, Mississippi 39201

WATER WELL DRILLERS LOG

9-10 date well completed 1971 Bond Well Drilling firm name CODED county well located

LANDOWNER: Richard Benson

description of formations encountered

from to

Brownville Miss (mailing address)

Red clay	0	30
gravel sand	30	102
Water sand	102	162

WELL LOCATION:

sec 6 T 6 N R 9 E

12 miles East of Brownville (distance) (direction) (nearest town)

WELL PURPOSE: Home (home, irrigation, municipal, industrial)

WELL COMPLETION DATA:

- (1) diameter (inches) 4
- (2) total depth (feet) 162
- (3) static water level (feet) 30 below top of ground.

(4) casing Steel 162 (material) (depth)

(size) if telescope see back.

(5) screen perforated copper (length) (depth to top)

(size) (material)

(6) pump 3/4 (HP) 5 (yield gpm)

Electric pump (type power)

(7) electric log no (yes or no)

(organization running log)

(8) how well bottom plugged plugged


DRILLERS REMARKS:

OCT 4 - 1971

MISS. BD. OF WATER COMMISSIONERS

If well telescopes please sketch and show depths.

GROUND LEVEL

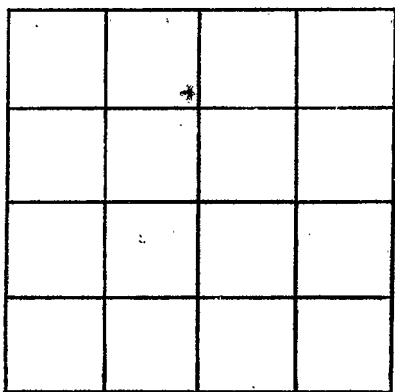

SECTION _____

Please indicate well location X.

ADDITIONAL INFORMATION

A series of horizontal lines for entering additional information, starting below the 'ADDITIONAL INFORMATION' header.

If more than one screen, show locations of each on sketch.