

Prentiss
 M13 ~~13~~
 12-66

MISSISSIPPI
 BOARD OF WATER COMMISSIONERS
 416 North State Street
 Jackson, Mississippi 39201

CODED

WATER WELL DRILLERS LOG

Dec. 21, 1966 date well completed
 Bonds Plumbing & Drilling Co. firm name
 Prentiss county well located
 Bear L take 1st pt.

LANDOWNER: Earle Harris
 Kossing Hollow Ch. Rd.
 728 1090

description of formations encountered

	from	to
Yellow Sand	0'	25'
Sandy Blue	25'	110'
Water Sand	110'	150'

Marion, Miss.
 (mailing address)


WELL LOCATION:
 31 sec 6 T 60 N R 9 E W
 2 miles W of Marion
 (distance) (direction) (nearest town)

WELL PURPOSE: Home
 (home, irrigation, municipal, industrial)

WELL COMPLETION DATA:

- diameter (inches) 11"
- total depth (feet) 150'
- static water level (feet) 55' below top of ground.
- casing (material) BK Steel, (depth) 25'
- screen (size) none, (length) none, (depth to top) none, (material) none
- pump (type power) none, (yield gpm) none
- electric log no (yes or no), (organization running log) none
- how well bottom plugged open


CODED

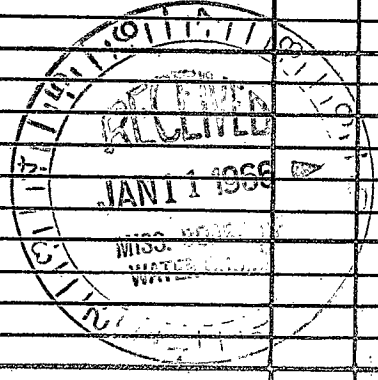

DRILLERS REMARKS:

If well telescopes please sketch and show depths.

GROUND LEVEL

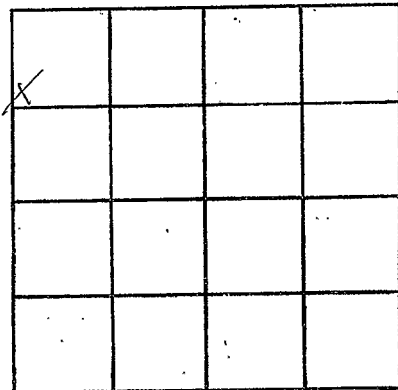

SECTION 31

Please indicate well location X.

ADDITIONAL INFORMATION

If more than one screen,
show locations of each on sketch.