

Prentiss

M14

3-9-72

MISSISSIPPI BOARD OF WATER COMMISSIONERS
416 North State Street
Jackson, Mississippi 39201

WATER WELL DRILLERS LOG

CODED

3-9

date well completed

1972 Bonds Well Drilling Prentiss

firm name

county well located

LANDOWNER:

Ruford Moore

description of formations encountered

from

to

New Seen Miss
(mailing address)

Red clay
Red sand
Water sand

0 2.6
2.6 147
86 147

WELL LOCATION:

sec. 16 T. 6 N. R. 9 E
12 miles East of Brownsville
(distance) (direction) (nearest town)

WELL PURPOSE:

Home
(home, irrigation, municipal, industrial)

WELL COMPLETION DATA:

- (1) diameter (inches) 4
- (2) total depth (feet) 147
- (3) static water level (feet) 62 below above top of ground.
- (4) casing Steel 147 (material) (depth)
(size) if telescope see back.
- (5) screen perforated Cast iron (length) (depth to top)
(size) (material)
- (6) pump 3/4 6 (HP) (yield gpm)
Electric pump (type power)
- (7) electric log no (yes or no)
(organization running log)
- (8) how well bottom plugged plug

CODED


APR 12 1972

MISS. SD. OF WATER COMMISSIONERS

DRILLERS REMARKS:

If well telescopes please sketch and show depths.

GROUND LEVEL

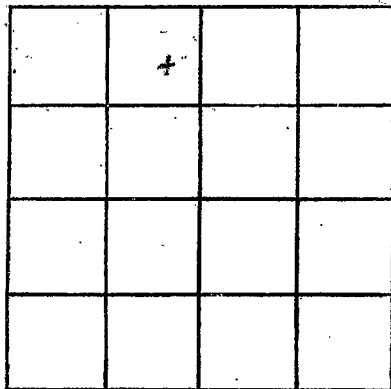

SECTION _____

Please indicate well location X.

ADDITIONAL INFORMATION

If more than one screen,
show locations of each on sketch.