

PRENTISS

M 2000

2-25-76

MISSISSIPPI BOARD OF WATER COMMISSIONERS  
416 North State Street  
Jackson, Mississippi 39201

WATER WELL DRILLERS LOG

2-25 1976 Bonds Well Drilling Prentiss  
date well completed firm name county well located


LANDOWNER: <u>Ronnie Eaton</u>	description of formations encountered	from	to
<u>New Site</u>	<u>Red Clay</u>	<u>0</u>	<u>20</u>
	<u>Yellow sand</u>	<u>20</u>	<u>90</u>
	<u>Blue Clay</u>	<u>90</u>	<u>150</u>
(mailing address)	<u>Water</u>	<u>150</u>	<u>175</u>
<b>WELL LOCATION:</b>			
sec. <u>18</u> T. <u>6</u> N R. <u>9</u> E			
<u>1</u> miles <u>N</u> of <u>New Site</u> (distance) (direction) (nearest town)			
<b>WELL PURPOSE:</b> <u>Home</u> (home, irrigation, municipal, industrial)			
<b>WELL COMPLETION DATA:</b>			
(1) diameter (inches) <u>4"</u>			
(2) total depth (feet) <u>175"</u>			
(3) static water level (feet) <u>50</u> <u>below</u> above top of ground.			
(4) casing <u>Plastic</u> , <u>100'</u> (material) (depth)			
_____ If telescope see back. (size)			
(5) screen <u>no</u> (length) (depth to top)			
_____ (size) _____ (material)			
(6) pump <u>1</u> <u>5 gpm</u> (HP) (yield gpm)			
<u>elect.</u> (type power)			
(7) electric log <u>no</u> (yes or no)			
_____ (organization running log)			
(8) how well bottom plugged <u>open</u>			
<b>DRILLERS REMARKS:</b>			

RECEIVED  
DEC 7 1978

MISS. BD. OF WATER COMMISSIONERS

If well telescopes please sketch and show depths.

GROUND LEVEL

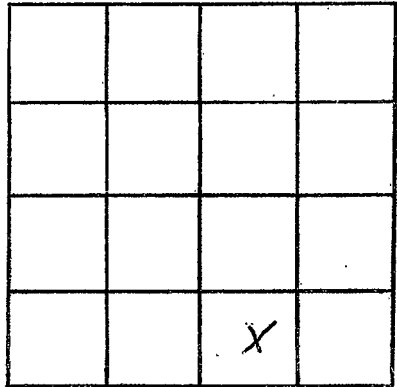

SECTION \_\_\_\_\_

Please indicate well location X.

ADDITIONAL INFORMATION

If more than one screen,  
show locations of each on sketch.