

PRENTISS

M 2001

8-13-77

MISSISSIPPI BOARD OF WATER COMMISSIONERS
416 North State Street
Jackson, Mississippi 39201

WATER WELL DRILLERS LOG

8-13 1977 Bonds Well Drilling Prentiss
date well completed firm name county well located

LANDOWNER: New Bethel Church

Booneville

(mailing address)

description of formations encountered

from

to

Red Clay	0	20
Yellow Sand	20	70
Water Sand	70	120
Gravel	120	130

WELL LOCATION:

sec. 10 T 6 N R 9 E
4 miles S of Burton
(distance) (direction) (nearest town)

WELL PURPOSE: Home
(home, irrigation, municipal, industrial)

WELL COMPLETION DATA:

- (1) diameter (inches) 4"
- (2) total depth (feet) 130
- (3) static water level (feet) _____ below above top of ground.

(4) casing Plastic, 130
(material) (depth)

_____ if telescope see back.
(size)

(5) screen Perforated
(length) (depth to top)

_____ (size) _____ (material)

(6) pump 3/4 10 gpm
(HP) (yield gpm)

odest
(type power)

(7) electric log no
(yes or no)

_____ (organization running log)

(8) how well bottom plugged plugged


DRILLERS REMARKS:

RECEIVED
DEC - 5 1978

MISS. BD. OF WATER COMMISSIONERS

If well telescopes please sketch and show depths.

GROUND LEVEL

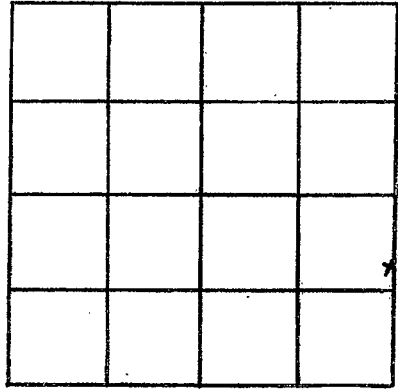

SECTION _____

Please indicate well location X.

ADDITIONAL INFORMATION

If more than one screen,
show locations of each on sketch.