




If well telescopes please sketch and show depths.

GROUND LEVEL

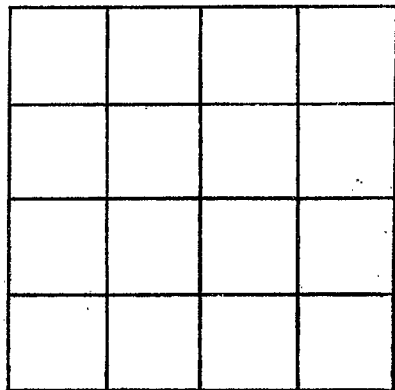

SECTION \_\_\_\_\_

Please indicate well location X.

ADDITIONAL INFORMATION

If more than one screen, show locations of each on sketch.

MISSISSIPPI DEPARTMENT OF ENVIRONMENT QUALITY

Office of Land and Water Resources

P.O. Box 2309

Jackson, MS 39225

Water Well Plugging/Decommissioning Form

OLWR-DF-1 (4/08)

0600008-03

COUNTY WELL LOCATED: Quitman		WELL NUMBER: A0015	
PERMIT NUMBER: MS-GW-02214		DATE WELL PLUGGED: 02/9/2012	
NAME OF FIRM PLUGGED WELL: Mid-South Water and Machine Works, LLC TELEPHONE NUMBER: (662) 843-4078			
NAME AND ADDRESS OF CURRENT LANDOWNER: Town of Sledge P. O. Box 278 Sledge, MS 38670			
WELL LOCATION: SW/NE SECTION: 35 TOWNSHIP: 07S RANGE: 10W			
WELL LOCATION LATITUDE: N34° 25' 55.909"		LONGITUDE: W90° 13' 11.194"	
METHOD (CIRCLE ONE): (1) USGS QUAD (2) CONVENTIONAL SURVEY (3) GPS - HAND HELD OR SURVEY GRADE			
DISTANCE		DIRECTION	
WELL PURPOSE (HOME, IRRIGATION MUNICIPAL ETC):		Municipal	
NAME OF WELL CONTRACTOR WHO DRILLED THE WELL: Layne Central			
NAME OF LANDOWNER WHEN WELL WAS DRILLED:			

WELL DATA			
WELL DEPTH: 1420'		HOLE DEPTH:	
CASING DIAMETER (IN): 8"	CASING LENGTH (FT): 1350'	TYPE OF CASING: Steel	
DEPTH TO STATIC WATER LEVEL: 32'		DATE WELL COMPLETED: 1972	
WHY IS THE WELL BEING ABANDONED?: Non productive			

DESCRIBE HOW THE WELL OR HOLE WAS PLUGGED (AMOUNT OF CASING AND/OR SCREEN THAT WAS REMOVED OR LEFT IN HOLE MATERIAL AND AMOUNT USED IN PLUGGING METHOD OF PLACING MATERIAL ETC)

Pump pulled from well.

Bailed for oil. No oil found in well.

Pipe run to 1380'.

11 yd<sup>3</sup> of cement pumped from 1380' to ground surface.

Casing cut at ground level.

Split pier foundation left in place.

I CERTIFY THAT THE WELL WAS PLUGGED OR ABANDONED IN ACCORDANCE WITH THE STATE OF MISSISSIPPI REGULATIONS

Clayton Miller  
PRINT NAME

0-703  
MS LICENSE NUMBER

*Clayton Miller*  
SIGNATURE

02-13-2012  
DATE