

QUITMAN

A 16
8-2-65

WATER WELL DRILLERS LOG

CODED

QUITMAN

Date: 8-2, 1965, Driller: Fair County, James ^{Assn} County Quitman
(Name)

(1) Owner of Land: FR. STARR ^{RED}
(Name)
SLEDGE MISS
(Address)

(2) Location: 1/4, 1/4, Sec. 23 T 7 R 104
2 miles NW, of Sledge
(distance) (direction) (Nearest Town)

(3) Topography: Flat
(Hilly) (Flat) (Level)

(4) Purpose of Well: Irrigation
(Domestic Irrigation, Municipal, Industrial, Other)

Description & Color of Materials Sand, Clay, Red Clay, Shell, etc.	Thick- ness Feet	Depth Feet
TOP SOIL		14 1/2
Gray Clay	6 1/2	21
Fine Sand	17 1/2	38 1/2
Med + Fine Sand	6 1/2	45
Med. Sand + lignite	6 1/2	51 1/2
Med. Sand + gravel	6 1/2	58
Med. Sand + large gravel	45	103

Information upon completion of well:

(1) Diameter 6 inches.

(2) Total Depth 100 feet.


(3) Water Level 8' feet below top of ground.

(4) Cased to 52, Size 6

(5) Screen: Size 6, Length 48

(6) Were any formations sealed against pollution?
_____ yes, _____ no.

CODED

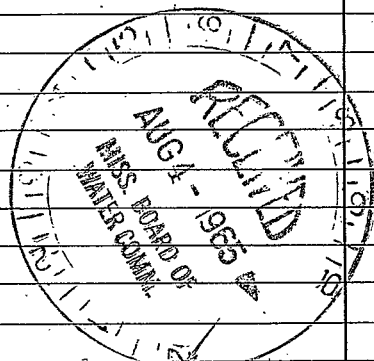

If YES depth of formation _____
Why _____

Drillers Remarks: _____

Drilled Casper Dick

(Use Back Side)

Well No.

