

Date: April 24, 19 62, Driller: Layne-Central Company County Quitman
 (Name)

(1) Owner of Land: Crenshaw Brothers
 (Name)
Crenshaw, Mississippi
 (Address)

(2) Location: 1/4, 1/4, Sec. 15 T7 R10W
6 miles southwest of Crenshaw,
 (distance) (direction) (Nearest Town)

(3) Topography: flat
 (Hilly) (Flat) (Level)

(4) Purpose of Well: irrigation
 (Domestic Irrigation
 Municipal, Industrial, Other)

Description & Color of Materials Sand, Clay, Red Clay, Shell, etc.	Thick- ness Feet	Depth Feet
Clay	18	18
Fine sand	4	22
Pink clay	22	44
Clay balls & fine sand	5	49
Medium sand	6	55
Coarse sand	23	78
Pea gravel	17	95
Gravel	13	108
Rock	2	110

Information upon completion of well:

(1) Diameter 12 inches.

(2) Total Depth 110 feet.

(3) Water Level 8' -6" feet below top of ground.


(4) Cased to 60', Size 12"

(5) Screen: Size 12", Length 50'

(6) Were any formations sealed against pollution?
no yes, No no.

If YES depth of formation _____
 Why _____
 Drillers Remarks: _____

CODED

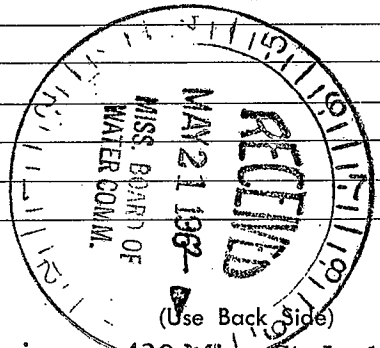

Well No.

