

Quitman
A 21

MISSISSIPPI BOARD OF WATER COMMISSIONERS

7-66

WATER WELL DRILLERS LOG

CODED

Quitman

Date: 7.14, 1966, Driller: For County Farmers Union County Caldwell
(Name)

(1) Owner of Land: Hanley Houze
(Name)
Sledge Miss
(Address)

(2) Location: SE 1/4, NW 1/4, Sec. 22 T5 R10
3 1/2 miles SW of Sledge
(distance) (direction) (Nearest Town)

(3) Topography: flat
(Hilly) (Flat) (Level)

(4) Purpose of Well: irrigation
(Domestic Irrigation Municipal, Industrial, Other)

Description & Color of Materials Sand, Clay, Red Clay, Shell, etc.	Thick- ness Feet	Depth Feet
<u>Clay + Bushshot</u>		<u>20 1/2</u>
<u>sand.</u>	<u>19 1/2</u>	<u>40</u>
<u>Sand + Gravel with</u>		
<u>layers of large gravel</u>		<u>65 1/2</u>
<u>gray back clay.</u>		<u>3 1/2</u>

CODED

Information upon completion of well:

(1) Diameter 16 inches.


(2) Total Depth 113' feet.

(3) Water Level 13' feet below top of ground.

(4) Cased to 65', Size 16"

(5) Screen: Size 16", Length 48"

(6) Were any formations sealed against pollution?
no.

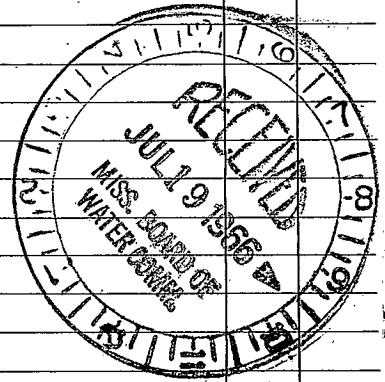

If YES depth of formation _____

Why _____

Drillers Remarks: _____

[Signature]

(Use Back Side)

Well No.

