

4/19/68
 22644

MISSISSIPPI
 BOARD OF WATER COMMISSIONERS
 416 North State Street
 Jackson, Mississippi 39201

WATER WELL DRILLERS LOG

CODED

Quitman
 A 22
 4-68

April 19, 19 68 Layne-Central Company Quitman
 date well completed firm name county well located

LANDOWNER: Clarence Overbay

description of formations encountered	from	to
Clay	0	27
Fine sand	27	32
Coarse sand and gravel	32	92

Coldwater, Mississippi
 (mailing address)


WELL LOCATION: NE 1/4 NW 1/4
 sec. 3 T. 7 N R. 10 E
 (S) (W)
 4 miles west of Crenshaw
 (distance) (direction) (nearest town)

WELL PURPOSE: irrigation
 (home, irrigation, municipal, industrial)

WELL COMPLETION DATA:

- (1) diameter (inches) 12
- (2) total depth (feet) 92
- (3) static water level (feet) 8' 7" above top of ground.
- (4) casing steel, 62' (material) (depth)
 12" (size) if telescope see back.
- (5) screen 30' (length), 62' (depth to top)
 12" (size), Armco (material)
- (6) pump 30 (HP), 1500 (yield gpm)
 engine (type power)
- (7) electric log no (yes or no)
 (organization running log)
- (8) how well bottom plugged plate


CODED

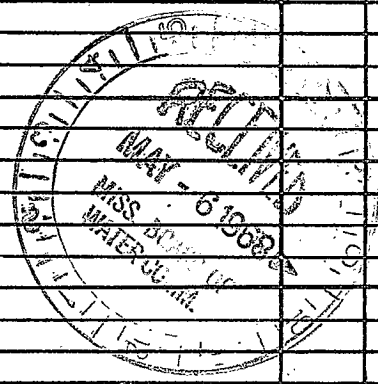

DRILLERS REMARKS:

If well telescopes please sketch and show depths.

GROUND LEVEL

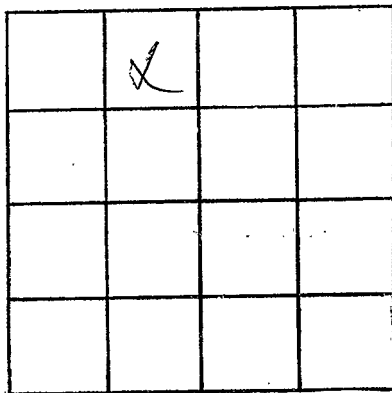

SECTION 3

Please indicate well location X.

ADDITIONAL INFORMATION

If more than one screen, show locations of each on sketch.