

QUITMAN

A 24

3-27-77

MISSISSIPPI BOARD OF WATER COMMISSIONERS  
416 North State Street  
Jackson, Mississippi 39201

WATER WELL DRILLERS LOG CODED

March 27

19 77

Layne Central Co.

Quitman

date well completed

firm name

county well located

LANDOWNER:

Howze Planting Co.

Sledge, MS

(mailing address)

description of formations encountered

from

to

Clay

0

33

Med. Sand & Pea Gravel

33

48

Fine Sand

48

53

Med. Sand & Pea Gravel

53

83

Coarse Sand & Gravel

83

113

#2 WELL LOCATION:

sec. 34 T. 7 N. R. 10 E. S. 5 W.

1 miles West of Sledge  
(distance) (direction) (nearest town)

WELL PURPOSE: Irrigation  
(home, irrigation, municipal, industrial)

WELL COMPLETION DATA:

- (1) diameter (inches) 16"
- (2) total depth (feet) 113'
- (3) static water level (feet) 15 below top of ground.

(4) casing Steel 73'  
(material) (depth)

16" If telescope see back.  
(size)

(5) screen 40' 73'  
(length) (depth to top)

16" Stainless Steel  
(size) (material)

(6) pump 40 1500  
(HP) (yield gpm)

diesel  
(type power)

(7) electric log No  
(yes or no)

(organization running log)

(8) how well bottom plugged Steel Plate

DRILLERS REMARKS:


CODED

RECEIVED  
MARCH 28 1977

MISS. Bd. OF WATER COMMISSIONERS

If well telescopes please sketch and show depths.

GROUND LEVEL

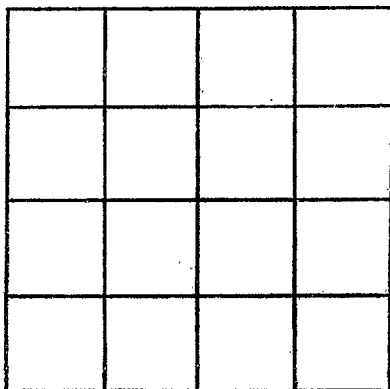

SECTION \_\_\_\_\_

Please indicate well location X.

ADDITIONAL INFORMATION

If more than one screen,  
show locations of each on sketch.