

QUITMAN
A 25
3-24-77

MISSISSIPPI
BOARD OF WATER COMMISSIONERS
416 North State Street
Jackson, Mississippi 39201

CODED

WATER WELL DRILLERS LOG

March 24 19 77 Layne Central Co. Quitman
date well completed firm name county well located

LANDOWNER:		description of formations encountered	from	to
Howze Planting Company Sledge, MS (mailing address)				
#1 WELL LOCATION:		Red Sand	19	21
sec. 34	T 7 N R 10	Fine Sand	21	28
	S W	Med. Sand & Pea Gravel	28	45
1	miles West of Sledge	Fine Sand	45	55
(distance)	(direction) (nearest town)	Med. Sand & Pea Gravel	55	58
WELL PURPOSE: Irrigation		Coarse Sand & Gravel	58	69
(home, irrigation, municipal, industrial)		Coarse Sand & Gravel	69	77
WELL COMPLETION DATA:		Fine Sand	77	97
(1) diameter (inches)	16"	Coarse Sand & Gravel	97	101
(2) total depth (feet)	113'	Coarse Sand & Gravel	101	113
(3) static water level (feet)	15' below top of ground.			
(4) casing (material)	Steel 73' (depth)			
	16" (size) if telescope see back.			
(5) screen (length)	40' 73' (depth to top)			
	16" (size) Stainless Steel (material)			
(6) pump (HP)	40 1500 (yield gpm)			
	diesel (type power)			
(7) electric log (yes or no)	No			
	(organization running log)			
(8) how well bottom plugged	Steel Pl.			
DRILLERS REMARKS:				


DEPARTMENT OF WATER CONTROL

JUN 23 1977

DEPARTMENT OF WATER CONTROL

If well telescopes please sketch and show depths.

GROUND LEVEL

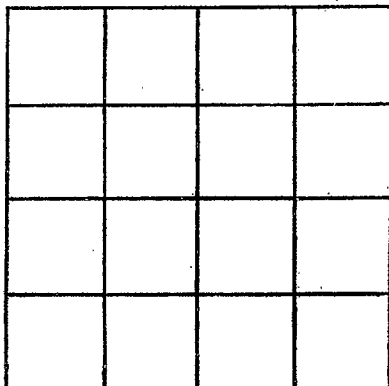

SECTION _____

Please indicate well location X.

ADDITIONAL INFORMATION

If more than one screen,
show locations of each on sketch.