

QUITMAN

JANICA
A 26
8-16-78

MISSISSIPPI
BOARD OF WATER COMMISSIONERS **CODED**

416 North State Street
Jackson, Mississippi 39201

QUITMAN

WATER WELL DRILLERS LOG

8-16-78 date well completed 19 78 Hester Drilling Co firm name JANICA MISS county well located

LANDOWNER: <u>W.D. GARRETT</u>	description of formations encountered	from	to
<u>Dumfries, Miss</u>			
(mailing address)	<u>lime sand</u>	<u>20</u>	<u>50</u>
	<u>colored sand & gravel</u>	<u>50</u>	<u>103</u>
	<u>iron sand</u>	<u>103</u>	<u>110</u>
WELL LOCATION:			
sec <u>3</u> T <u>7</u> N R <u>10</u> E			
<u>12</u> miles <u>SE</u> of <u>Dumfries</u>			
(distance) (direction) (nearest town)			
WELL PURPOSE: <u>Domestic</u>			
(home, irrigation, municipal, industrial)			
WELL COMPLETION DATA:			
(1) diameter (inches) <u>12"</u>			
(2) total depth (feet) <u>103</u>			
(3) static water level (feet) <u>12</u> ^{below} _{above} top of ground.			
(4) casing <u>steel</u> <u>103'</u>			
(material) (depth)			
<u>12"</u> if telescope see back.			
(size)			
(5) screen <u>40'</u> <u>103'</u>			
(length) (depth to top)			
<u>12"</u> <u>steel</u>			
(size) (material)			
(6) pump <u>30</u> <u>2000</u>			
(HP) (yield gpm)			
<u>Electric</u>			
(type power)			
(7) electric log <u>None</u>			
(yes or no)			
(organization running log)			
(8) how well bottom plugged <u>Plata</u>			
DRILLERS REMARKS:			

CODED


RECEIVED

SEP 18 1978

MISS. BD. OF WATER COMMISSIONERS

If well telescopes please sketch and show depths.

GROUND LEVEL

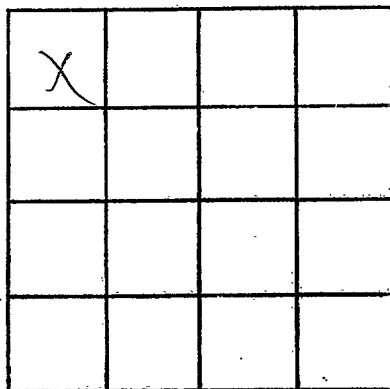

SECTION _____

Please indicate well location X.

ADDITIONAL INFORMATION

If more than one screen,
show locations of each on sketch.