

Quitman
A 53
4-7-81

MISSISSIPPI
BOARD OF WATER COMMISSIONERS
416 North State Street
Jackson, Mississippi 39201

CODED

Quitman

WATER WELL DRILLERS LOG

4-7-81 1981 *Hester Drilling* ~~Quitman~~
date well completed firm name county well located

LANDOWNER: *Crenshaw Road*
Crenshaw, Miss
(mailing address)

description of formations encountered	from	to
	<i>Clay + Gumbo</i>	<i>0</i>
<i>Hard sand</i>	<i>32</i>	<i>53</i>
<i>Coarse sand + gravel</i>	<i>53</i>	<i>100</i>

WELL LOCATION:
sec. *19* T. *7* N. R. *10* E
6 1/2 miles *S* West of *Crenshaw*
(distance) (direction) (nearest town)

WELL PURPOSE: *Drain*
(home, irrigation, municipal, industrial)

- WELL COMPLETION DATA:
- (1) diameter (inches) *12 in*
 - (2) total depth (feet) *100*
 - (3) static water level (feet) *15* below above top of ground
 - (4) casing *Steel 60*
(material) (depth)
(size) If telescope see back.
 - (5) screen *40 60*
(length) (depth to top)
12 Steel
(size) (material)
 - (6) pump *40 2000*
(HP) (yield gpm)
Electric
(type power)
 - (7) electric log *no*
(yes or no) *no*
(organization running log)
 - (8) how well bottom plugged *Steel plate*

DRILLERS REMARKS:
Real Hard Formation


CODED

DEPT. OF NATURAL RESOURCES
BUREAU OF LAND & WATER RESOURCES

MAY -7 1981
RECEIVED

If well telescopes please sketch and show depths.

GROUND LEVEL

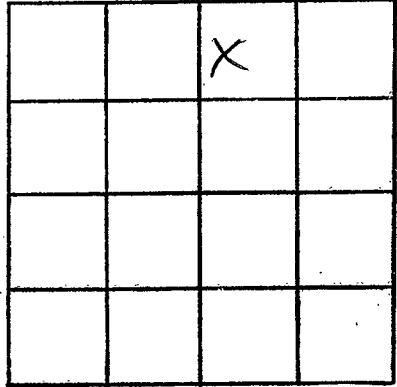

SECTION _____

Please indicate well location X.

ADDITIONAL INFORMATION

If more than one screen, show locations of each on sketch.