

**MISSISSIPPI DEPARTMENT OF NATURAL RESOURCES**  
**Bureau of Land and Water Resources**  
 Southport Mall  
 P.O. Box 10631  
 Jackson, Mississippi 39209  
**WATER WELL DRILLERS LOG**

A63  
Quitman  
6-16-84

**CODED**

6/16 1989 Bowell Irrigation Quitman  
 date well completed firm name county well located

LANDOWNER:	description of formations encountered	from	to
<u>Washington</u>			
	<u>CLAY</u>	<u>0</u>	<u>30</u>
	<u>Med + Coarse Sand</u>	<u>30</u>	<u>60</u>
	<u>Coarse Sand + Gravel</u>	<u>60</u>	<u>100</u>

**WELL LOCATION:**  
 sec. 20 T. 7 N R. 10 E  
 (S) (W)  
4 miles NE of Sledge  
 (distance) (direction) (nearest town)

**WELL PURPOSE:** Drinking  
 (home, irrigation, municipal, industrial)

- WELL COMPLETION DATA:**
- (1) diameter (inches) 12"
  - (2) total depth (feet) 100'
  - (3) static water level (feet) 13' below above top of ground.
  - (4) casing Steel, 60'  
 (material), (depth)  
 (size) If telescope see back.
  - (5) screen 40', 60'  
 (length), (depth to top)  
12", Steel  
 (size), (material)
  - (6) pump 60 2000  
 (HP) (yield gpm)  
diesel  
 (type power)
  - (7) electric log NO  
 (yes or no)  
 (organization running log)
  - (8) how well bottom plugged Steel Plate

**CODED**

DEPT. OF NATURAL RESOURCES  
 BUREAU OF LAND & WATER RESOURCES


**JUL 10 1984**

**RECEIVED**

**DRILLERS REMARKS:**

If well telescopes please sketch and show depths.

GROUND LEVEL

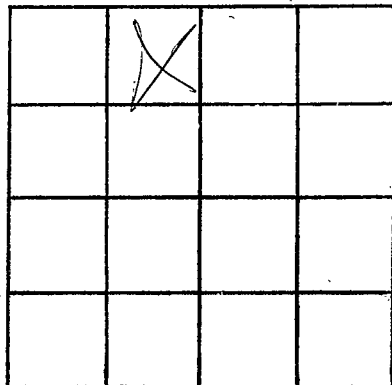

SECTION 20

Please indicate well location X.

ADDITIONAL INFORMATION

If more than one screen,  
show locations of each on sketch.