

MISSISSIPPI DEPARTMENT OF NATURAL RESOURCES

Bureau of Land and Water Resources

Southport Mall

P.O. Box 10631

Jackson, Mississippi 39209

WATER WELL DRILLERS LOG

CODL

CODED

ACA
 Quitman Co.
 6-17-84

6/17 1984 Rowlett Enterprises Quitman
 date well completed firm name county well located

LANDOWNER: Wallington
 (mailing address)

description of formations encountered	from	to
Clay	0	30
Med. Sand & Gravel	30	60
Coarse Sand & Gravel	60	100

WELL LOCATION:
 sec. 17 T 7 N R. 10 E
6 miles NW of Steele
 (distance) (direction) (nearest town)

WELL PURPOSE: irrigation
 (home, irrigation, municipal, industrial)

WELL COMPLETION DATA:

(1) diameter (inches) 12"

(2) total depth (feet) 100'

(3) static water level (feet) 15' ^{below} top of ground.

(4) casing Steel 60'
 (material) (depth)

_____ if telescope see back.
 (size)

(5) screen 40' 60'
 (length) (depth to top)

12" Steel
 (size) (material)

(6) pump 60 2000
 (HP) (yield gpm)

diesel
 (type power)

(7) electric log NO
 (yes or no)

_____ (organization running log)

(8) how well bottom plugged steel plate

CODED


DEPT. OF NATURAL RESOURCES
 BUREAU OF LAND & WATER RESOURCES

JUL 10 1984
 RECEIVED

DRILLERS REMARKS:

If well telescopes please sketch and show depths.

GROUND LEVEL

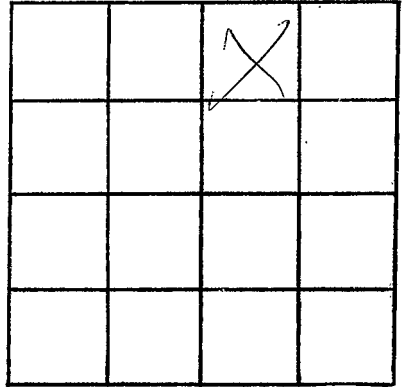

SECTION 12

Please indicate well location X.

ADDITIONAL INFORMATION

If more than one screen,
show locations of each on sketch.