

MISSISSIPPI DEPARTMENT OF NATURAL RESOURCES
Bureau of Land and Water Resources
 Southport Mall
 P.O. Box 10631
 Jackson, Mississippi 39209
WATER WELL DRILLERS LOG

CODED

QUITMAN
CL-2597
AG5

5/17 19 84 LAYNE-CENTRAL CO. QUITMAN
 date well completed firm name county well located

LANDOWNER:	description of formations encountered	from	to
WADLINGTON FARMS			
SLEDGE, MS	brown sand	19	35
(mailing address)	coarse sand gravel	35	108
	gravel cemented	108	114
WELL LOCATION:			
sec. 21 T. 7 S. R. 10 E. W.			
4 miles NW of Sledge			
(distance) (direction) (nearest town)			
WELL PURPOSE: irrigation			
(home, irrigation, municipal, industrial)			
WELL COMPLETION DATA:			
(1) diameter (inches) 32"			
(2) total depth (feet) 114'			
(3) static water level (feet) 10' below top of ground.			
(4) casing steel, 64' (material), (depth)			
16" (size) if telescope see back.			
(5) screen 50' (length), 64' (depth to top)			
16" (size), st. steel (material)			
(6) pump 40 (HP), 2,000 (yield gpm)			
diesel (type power)			
(7) electric log no (yes or no)			
(organization running log)			
st. plate			
(8) how well bottom plugged			
DRILLERS REMARKS:			

CODED


DEPT. OF NATURAL RESOURCES
 BUREAU OF LAND & WATER RESOURCES

SEP 21 1984

RECEIVED

If well telescopes please sketch and show depths.

GROUND LEVEL

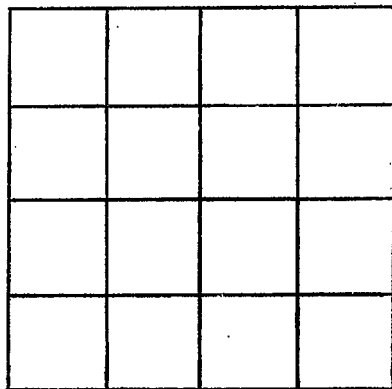

SECTION _____

Please indicate well location X.

ADDITIONAL INFORMATION

If more than one screen,
show locations of each on sketch.