

QUITMAN  
 CT-2925 A66

MISSISSIPPI DEPARTMENT OF NATURAL RESOURCES  
 Bureau of Land and Water Resources  
 Southport Mall  
 P.O. Box 10631  
 Jackson, Mississippi 39209  
**WATER WELL DRILLERS LOG**

CODED

4/9 19 85 LAYNE-CENTRAL QUITMAN  
 date well completed firm name county well located

LANDOWNER:  
 WADLINGTON FARMS  
 SLEDGE, MS  
 (mailing address)

description of formations encountered	from	to
clay	0	12
fine sand	12	32
coarse sand/pea gravel	42	72
coarse sand/gravel	72	106
clay	106	112

WELL LOCATION:  
 sec. 18 T 7 S R 10 E  
 5 miles NW of Sledge  
 (distance) (direction) (nearest town)

CODED

WELL PURPOSE: irrigation  
 (home, irrigation, municipal, industrial)

WELL COMPLETION DATA:

(1) diameter (inches) 32"  
 (2) total depth (feet) 106'  
 (3) static water level (feet) 16' below top of ground.  
 (4) casing steel 56' (material), (depth)  
 16" (size) if telescope see back.  
 (5) screen 50' 56' (length), (depth to top)  
 16" st. steel (size), (material)  
 (6) pump 40 2000 (HP), (yield gpm)  
 diesel (type power)  
 (7) electric log no (yes or no)  
 (organization running log) st. plate  
 (8) how well bottom plugged


RECEIVED  
 JUL 8 - 1985

DRILLERS REMARKS:

Department of Natural Resources  
 Bureau of Land & Water Resources

If well telescopes please sketch and show depths.

GROUND LEVEL

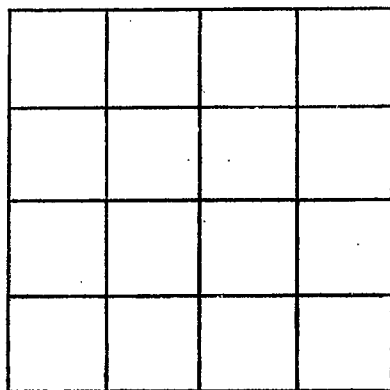

SECTION \_\_\_\_\_

Please indicate well location X.

ADDITIONAL INFORMATION

If more than one screen,  
show locations of each on sketch.