

MISSISSIPPI DEPARTMENT OF ENVIRONMENTAL QUALITY
Office of Land and Water Resources

P. O. Box 10631
Jackson, MS 39289-0631
WATER WELL DRILLERS LOG

COUNTY WELL LOCATED <i>Franklin</i>		PERMIT NUMBER
WELL NUMBER <i>2</i>	CODED	NAME OF DRILLING FIRM <i>DELTA DRILLING OF Tunica</i>
DATE WELL COMPLETED <i>4/9/04</i>		

NAME & MAILING ADDRESS OF LANDOWNER <i>SAM Rowley</i> <i>P.O. Box 66</i> <i>CRENSHAW MS.</i>		
WELL LOCATION: SEC	TOWNSHIP	RANGE
<i>13</i>	<i>7</i>	<i>810 E</i>
DISTANCE <i>1/2</i> Miles	DIRECTION <i>SOUTH</i>	NEAREST TOWN <i>CRENSHAW</i>
OTHER LANDMARK		
WELL PURPOSE: Home Irrigation, Municipal, Industrial, Fish Pond, etc.		

PUMP DATA		
PUMP TYPE (Circle One): Submersible, <u>Turbine</u> , Jet, Flowing Well, Other (Describe)		
POWER TYPE (Circle One): <u>Electric</u> , Tractor, Diesel, Gasoline, Butane, Other (Describe) <i>H/P 50</i>		
Pump Capacity (GPM)	No. of Stages	Setting Depth FT.
PUMP TEST		
Well yielded _____ GPM with a drawdown of _____ ft. after _____ hours of pumping		

WELL DATA		
Well Depth <i>110</i>	Casing Diameter (In.) <i>16"</i>	Casing Length (Ft.) <i>70'</i>
Type of Casing <i>STEEL</i>	Hole Depth <i>109</i>	Depth to Static Water Level <i>19'</i>
TYPE OF COMPLETION: (Circle One or More): <u>Gravel Packer</u> , Underreamed, Telescoped, Natural Development, Open Hole, Other (Describe)		

LOG DATA	
TYPE OF LOG RUN (Circle One): No Log Run, Electric, Gamma Ray, Density, Sonic, Neutron, Other (Describe) <u>Rustal</u>	
Name of Organization Running Log	

WELL GROUTED TO A DEPTH OF <u>10</u> FEET Type Grout (circle one): Cement, Bentonite, or Mix

GEOLOGIC DATA (Office Use Only)			
Surface Elev.	Geologic Unit	Unit Thickness	Depth to Top
Subs. SWL	Date	Analysis	Aquifer Test

SCREEN DATA		
Diameter - Inches <i>16</i>	Length - Feet <i>40</i>	Slot Size - Inches <i>045</i>
Screen Type <i>STEEL</i>	Depth to Bottom - Feet <i>110</i>	


Driller's Remarks <i>This well is in good course formation</i>
Top of Lap Pipe or Reduction in Casing FEET - <input type="checkbox"/> IF TELESCOPED OR MORE THAN ONE SCREEN: USE BACK PAGE

DESCRIPTION OF FORMATIONS ENCOUNTERED	FROM	TO
<i>Clay</i>	<i>0</i>	<i>50</i>
<i>fine sand</i>	<i>50</i>	<i>70</i>
<i>Coarse sand</i>	<i>70</i>	<i>110</i>
<i>Gravel</i>		

FORMATIONS (Continued)	FROM	TO
RECEIVED		
MAY 24 2004		
BY: OLWR		

If well telescopes please
sketch and show depths.

GROUND LEVEL

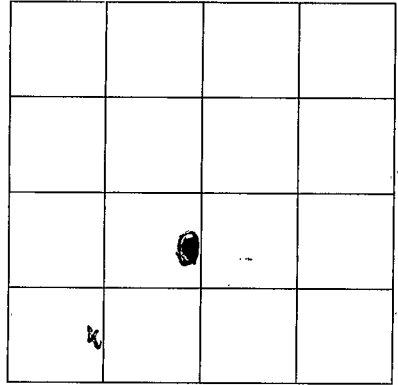

SECTION 13

Please indicate well location X.

ADDITIONAL INFORMATION

If more than one screen,
show location of each on sketch.