

State Well Report

Part I - Driller's Log

Mississippi Department of Environmental Quality
Office of Land and Water Resources
P.O. Box 2309
Jackson, MS 39225
(601)961- 5210
(601)961- 5228 (fax)

For Office Use Only:

Aquifer: A 104

Well #: _____

L. S. Elevation: _____

E-log #: _____

County: Quitman
Permit #: GW 48812
Driller: TERRY COATS
Date drilling completed: 6/15/15

State Law requires that this report be prepared by the license holder responsible for the work and filed with the Department at the above address within 30 days of completion of drilling of the well or borehole.

Information on Well Owner (Landowner if borehole is not for a water well)	Well or Borehole Location
Owner Name: <u>Sam Presley</u>	Latitude: <u>34° 27' 21"</u> Longitude: <u>90° 14' 46"</u>
Mailing Address: _____	Method of Lat/Long (circle one): Conventional Survey, USGS quad, Hand-held GPS, Survey-grade GPS
<u>PO. Box 66</u>	<u>SW 1/4 SW 1/4 Sec 22 Twn 07S Rng 10W</u>
<u>Crenshaw MS 39621</u>	Distance: <u>4</u> Miles Direction: <u>NW</u> of Nearest Town: <u>Steag</u>
City State Zip Code	
Telephone No. () _____	

Well / Borehole Data

Date drilling started: 6/15/15 Date drilling completed: 6/15/15 Hole depth: 100 Hole diameter: 28

Location of the source of any surface water used for drilling: nearest well
Method of dosing and volume of Chlorine used in drilling and development: _____

Logs run (circle all applicable): No log run Electric Gamma Ray Density Sonic Neutron Other: _____
Name of organization running log(s): _____

Purpose of borehole (check one): Water Well Geotechnical/Geological Investigation _____ Ground Source Heat Pump _____
Seismic Survey _____ Other (describe) _____

If drilling is not related to water well construction, skip the remainder of this block

Purpose of Well (check one): Home _____ Industrial _____ Public Supply _____ Irrigation Fish Culture _____ Other: _____

If a flowing well, method of flow regulation: Valve _____ Other (describe) _____

Static Water Level: 18 feet above or below (circle one) land surface Date measured: 6/15/15

Method of Measurement (circle one) steel tape electric tape air line other: _____

Well depth: 100 Well grouted to a depth of 10 feet Type of grout (circle one): Neat Cement Bentonite Mix

Casing length: 60 feet Casing diameter: 5 1/2 inches Type of casing: P.V.C

Screen length: 40 feet Screen diameter: 16 inches Type of screen: P.V.C

Screen slot size: 0.50 inches Setting depth: From 0 feet to 100 70 feet

Type of completion (circle all applicable): Gravel packed Underreamed Telescoped Open hole Natural Development

Other (describe): _____

Top of lap pipe or reduction in casing: _____ feet. *If telescoped or more than one screen, describe on next page*

Form: OLWR-SWR-1A (04/08)

RECEIVED
JUN 17 2015
BY OLWR

STATE WELL REPORT

Part 2

Pump Installer's Completion Report

Mississippi Department of Environmental Quality
Office of Land and Water Resources
P.O. Box 2309
Jackson, MS 39225-2309
(601)961-5210
(601) 360-0535 (fax)

For Office Use Only:

Well #: A1C4

Aquifer: _____

County: QUETMAN
 Permit #: GW-48812
 Driller: JOEL JUMPER / RANCO
 Date completed: 6-15-15
 Copy information from block on Part 1

This part of the report must be completed by a licensed water well contractor or a licensed pump installer. A copy of Part 1 of the report must be attached and both parts filed with the Department at the above address within 30 days of well completion.

Well Owner Information	Well Location
Owner Name: <u>PRESLEY FARMS</u>	Latitude: <u>34° 27.18"</u> Longitude: <u>90° 14.48"</u>
Mailing Address: <u>P.O. BOX 66</u>	Method of Lat/Long (check one): Conventional Survey _____, USGS quad _____, Hand-held GPS _____, Survey-grade GPS _____
<u>CRANSHAW</u> <u>MS</u> <u>38621</u>	<u>SW</u> ¼ <u>SW</u> ¼, Sec <u>22</u> T. <u>07S</u> R. <u>10W</u>
City State Zip Code	<u>2</u> Miles <u>NW</u> of <u>SLUDGE</u>
Telephone No. <u>(662) 382-5394</u>	(Distance) (Direction) (Nearest Town)

Pump Type (circle one)

Submersible Turbine Air Lift Centrifugal Flowing Well Jet Piston Rotary Other (describe): _____

Date Pump Installed: 6-16-15 Rated Pump Capacity: _____ Gallons Per Minute

Is This Pump (circle one): New Repaired Replacement USED

Power Type (circle one)

Electric Diesel Gasoline Natural Gas Tractor PTO Windmill Other (describe): _____

Horse Power Rating of Motor: 40 Setting Depth: 60 feet Number of Stages: 3

Pump Test Data for Non Flowing Well

Date Well Tested: _____ Duration of Pump Test (minimum 4 hours): _____ hours

Static Water Level (A): 16 Feet Below Land Surface Pumping Water Level (B): _____ Feet Below Land Surface

Drawdown [(B) - (A)]: _____ Feet Below Land Surface Test Pumping Rate: _____ Gallons Per Minute

Method of measurement (circle one): Steel tape Electric tape Air line Other (describe): _____

Pump Test Data for Flowing Well

Measured shut in head: _____ feet.

Well yielded _____ GPM with a drawdown of _____ feet after _____ hours of pumping

Meter Installation

Meter Manufacturer: _____ Meter Serial Number: _____

Meter Model Number/Name: _____ Type of Meter: _____

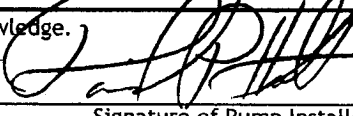
Totalizer Register Unit and Multiplier Factor (AF x .001, gal x 1000, etc): _____

Installation Date: _____ Meter installed by: _____

Is This Meter (circle one): New Repaired Replacement

Important: By submitting the above information you are certifying that this meter was installed to manufacturer standards. For agricultural wells, a list of approved meters is on the MDEQ website.

I HEREBY CERTIFY that the above statements are true to the best of my knowledge.

DAVID P. HOLT 0-7529 7-3-15 

Print Name of Pump Installer and License No. (if applicable) Date Signature of Pump Installer

RECEIVED

BY OLWR

15-0311
-0101