

STATE WELL REPORT

For Office Use Only:

County: Quitman
 Permit #: GW-51370
 Driller: Irrigation Equipment, Inc.
 Date drilling completed: 11-4-20

Part 1
Driller's Log
 Mississippi Department of Environmental Quality
 Office of Land and Water Resources
 P.O. Box 2309
 Jackson, MS 39225-2309
 (601) 961-5210
 (601) 360-0535 (fax)

Well #: A 113
 Aquifer: _____
 E-Log #: _____

State Law requires that this report be prepared by the license holder responsible for the work and filed with the Department at the above address within 30 days of completion of drilling of the well or borehole.

Well Owner Information <i>(Landowner if borehole is not for a water well)</i>			Well or Borehole Location	
Owner Name: <u>Maroon Crenshaw III LLC</u>			Latitude: <u>34° 28' 2.7"N</u>	Longitude: <u>90° 12' 15.6"W</u>
Mailing Address: <u>P.O. Box 1720</u>			Method of Lat/Long (check one): <input type="checkbox"/> Conventional Survey,	
<u>Collierville</u>	<u>TN</u>	<u>38027</u>	<input type="checkbox"/> USGS quad, <input checked="" type="checkbox"/> Hand-held GPS, <input type="checkbox"/> Survey-grade GPS	
City	State	Zip code	<u>MW</u> <u>NE</u> <u>1/4</u> , Sec <u>24</u> T <u>7S</u> R <u>10W</u>	
Telephone No. () -			Miles <u>NW</u> of <u>Sledge</u>	(Distance) (Direction) (Nearest Town)

Well / Borehole Data

Date drilling started: 11-4-20 Date drilling completed: 11-4-20 Hole depth: 118' Hole diameter: 24"

Location of the source of any surface water used for drilling: Surface Water

Method of dosing and volume of Chlorine used in drilling and development: 50 PPM

Logs run (check all applicable): No log run Electric Gamma Ray Density Sonic Neutron Other: _____

Name of organization running log(s): _____

Purpose of borehole (check one): Water Well Geotechnical/Geological Investigation Ground Source Heat Pump
 Seismic Survey Other (describe) _____

If drilling is not related to water well construction, skip the remainder of this block

Purpose of Well (check all applicable): Home Industrial Public Supply Irrigation Fish Culture

Other (describe): _____

If a flowing well, method of flow regulation: Valve _____ Other (describe) _____

Static Water Level: 17 feet [above or below] land surface Date measured: 11-4-20
 (check one)

Method of Measurement (check one) Steel tape Electric tape Air line Other: (describe) _____

Well depth: 118' Well grouted to a depth of: 10 feet Type of grout (check one): Neat Cement Bentonite Mix

Casing length: 78 feet Casing diameter: 16 inches Type of casing: PVC

Screen length: 40 feet Screen diameter: 16 inches Type of screen: PVC

Screen slot size: .050 inches Setting depth: From 79 feet to 118 feet

Type of completion (check all applicable): Gravel packed Underreamed Open hole Natural Development

Other (describe): _____

Top of lap pipe or reduction in casing: _____ Feet


RECEIVED
MAR 01 20
BY OLV

If telescoped or more than one screen, describe on next page

County: Quitman
 Permit #: GW-51370

For Office Use Only:
 Well #: _____

*The sketch below only required for water wells
 If well telescopes, show depths on sketch.*

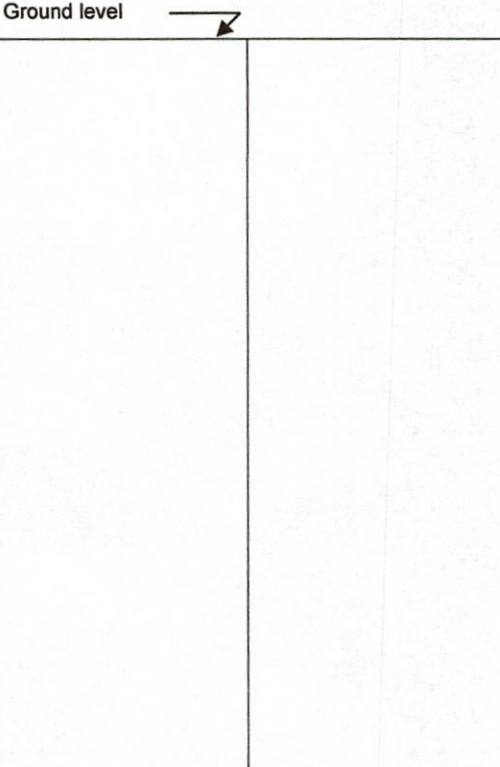

Description of formations encountered must be provided for all wells and boreholes, unless specifically exempted by regulations

Description of Formations Encountered	From (depth)	To (depth)
Clay	Ground level	30
Fine Sand & Gravel	31	44
Med. Sand & Gravel	45	115
Fine Sand	116	118

If more than one screen, show location of each on sketch

Sketch the property layout and include the following:
 1) the well location
 2) any permanent structures on the property that may aid in locating the well
 3) any roads, power lines, or other items that may aid in locating the property and the well
 4) a north arrow

RECEIVED
 MAR 01 2021
 BY OLWR

Landowner Name: _____

I HEREBY CERTIFY that the well/borehole was drilled, constructed, and completed in accordance with all applicable requirements of the Mississippi Department of Environmental Quality and the Mississippi Department of Health regulations, if applicable, and state laws.

Print Name of Responsible Licensee and License No. _____ Date _____ Signature of Licensee _____

Form: OLWR-SWR-1A (04/08)
 Form: OLWR-SWR-1A (4/13)

County: Quitman
Permit #: GW-51370
Driller: Irrigation Equipment, Inc.
Date drilling completed: 11-4-20
Copy information from block on Part 1

STATE WELL REPORT
Part 2
Pump Installer's Completion Report
Mississippi Department of Environmental Quality
Office of Land and Water Resources
P.O. Box 2309
Jackson, MS 39225-2309
(601) 961-5210
(601) 360-0535 (fax)

For Office Use Only:
Well #: A 113
Aquifer: _____

This part of the report must be completed by a licensed water well contractor or a licensed pump installer. A copy of Part 1 of the report must be attached and both parts filed with the Department at the above address within 30 days of well completion.

Well Owner Information	Well Location
Owner Name: <u>Maroon Crenshaw III LLC</u>	Latitude: <u>34° 28' 2.7"N</u> Longitude: <u>90° 12' 15.6"W</u>
Mailing Address: <u>P.O. Box 1720</u>	Method of Lat/Long (check one): <input type="checkbox"/> Conventional Survey, <input type="checkbox"/> USGS quad, <input checked="" type="checkbox"/> Hand-held GPS, <input type="checkbox"/> Survey-grade GPS
<u>Collierville</u> <u>TN</u> <u>38027</u> City State Zip code	<u>NW</u> $\frac{1}{4}$ <u>NE</u> $\frac{1}{4}$, Sec <u>24</u> T <u>7S</u> R <u>10W</u>
Telephone No. () -	Miles <u>NW</u> of <u>Sledge</u> (Distance) (Direction) (Nearest Town)

Pump Type (check one)
 Submersible Turbine Air Lift Centrifugal Flowing Well Jet Piston Rotary Other (describe): _____
Date Pump Installed 11-4-20 Rated Pump Capacity: 2000 +/- Gallons Per Minute
Is This Pump (check one): New Repaired Replacement

Power Type (check one)
 Electric Diesel Gasoline Natural Gas Tractor PTO Windmill Other (describe): _____
Horse Power Rating of Motor: 60 Setting Depth: 70 feet Number of Stages: 2

Pump Test Data for Non Flowing Well
Date Well Tested: _____ Duration of Pump Test (minimum 4 hours): _____ Hours
Static Water Level (A): _____ Feet Below Land Surface Pumping Water Level (B): _____ Feet Below Land Surface
Drawdown [(B) - (A)]: _____ Feet Below Land Surface Test Pumping Rate: _____ Gallons Per Minute
Method of measurement (check one): Steel tape Electric tape Air line Other (describe): _____

Pump Test Data for Flowing Well
Measured shut in head: _____ Feet
Well yielded _____ GPM with a drawdown of _____ feet after _____ hours of pumping

Meter Installation
Meter Manufacturer: _____ Meter Serial Number: _____
Meter Model Number/Name: _____ Type of Meter: _____
Totalizer Register Unit and Multiplier Factor (AF x .001, gal x 1000, etc): _____
Installation Date: _____ Meter installed by: _____
Is This Meter (check one): New Repaired Replacement
*Important: By submitting the above information you are certifying that this meter was installed to manufacturer standards.
For agricultural wells, a list of approved meters is on the MDEQ website.*

I HEREBY CERTIFY that the above statements are true to the best of my knowledge.
0695 _____
Print Name of Pump Installer and License No. (if applicable) Date
Signature of Pump Installer
Form: OLWR-SWR-1B (4/13)

RECEIVED
MAR 11 2021
BY OLWR



Department of Environmental Quality
Office of Land and Water Resources

CERTIFICATE OF PERMIT COVERAGE

*Under Mississippi's GROUNDWATER WITHDRAWAL GENERAL PERMIT
TO WITHDRAW groundwater from the Mississippi River Valley Alluvial Aquifer
FOR the beneficial use of Irrigation, Aquaculture, or Enhancement of Wildlife Habitat*

General Permit: MRVA-002
Certificate Number: MS-GW-51370
Total Permitted Acreage: 125

Landowner Name: MAROON CRENSHAW III LLC
Landowner Address: PO BOX 1720
LAND MANAGEMENT GROUP
COLLIERVILLE, TN 38027

Source of Water: MISSISSIPPI RIVER VALLEY ALLUVIAL AQUIFER
Beneficial Use(s): IRRIGATION

Diversion/Withdrawal Location: SW 1/4 of the SE 1/4 **Section:** 13 **Township:** 07S **Range:** 10W

County: QUITMAN **Quadrangle:** CRENSHAW SOUTH

Permitted Acreage: **Irrigation:** 125 **Fish Culture:** 0 **Wildlife Management:** 0

Maximum Volume: See Special Terms And Conditions (attachment I)

Applicant Name: MAROON CRENSHAW III LLC
Applicant Address: PO BOX 1720
LAND MANAGEMENT GROUP
COLLIERVILLE, TN 38027

RECEIVED
MAR 01 2021
BY OLWR

Date Original Permit Issued: 11/04/2020

Date Coverage Expires: 09/17/2023

Date Coverage Modified:

Date Coverage Granted:

SPECIAL TERMS AND CONDITIONS 1:

See Attachment I which is hereby declared part of this permit.

SPECIAL TERMS AND CONDITIONS 2:

REPLACEMENT WELL FOR MS-GW-36741

Kay Whittington, Director
Office of Land and Water Resources



3 2000 ft

Hwy 3

Robert Holder Rd

Siglar Rd

County Line Rd

34 28 2.7N 90 12 15.6W



RECEIVED
MAR 01 2021
BY OLWR

Old Crenshaw Rd

Google Earth

© 2020 Google