

MISSISSIPPI DEPARTMENT OF NATURAL RESOURCES

Bureau of Land and Water Resources

Southport Mall

P.O. Box 10631

Jackson, Mississippi 39209

WATER WELL DRILLERS LOG

QUITMAN
A 2000

Powell slr

Quitman

Oct 1986
date well completed

firm name

county well located

LANDOWNER:
Wadlington Farms
Sledge road
(mailing address)

description of formations encountered

from	to
<u>0</u>	<u>13</u>
<u>13</u>	<u>33</u>
<u>33</u>	<u>105</u>

Clay
fine sand
Coarse sand
& gravel

WELL LOCATION:

sec 20 T 7 S R 10 E
6 miles W of Sledge
(distance) (direction) (nearest town)

WELL PURPOSE: slr
(home, irrigation, municipal, industrial)

WELL COMPLETION DATA:

- (1) diameter (inches) 12
- (2) total depth (feet) 105
- (3) static water level (feet) 14 below above top of ground.
- (4) casing steel, 65,
(material) (depth)
(size) if telescope see back.
- (5) screen 40, 65
(length) (depth to top)
12, steel
(size) (material)
- (6) pump 40, 1500
(HP) (yield gpm)
diesel
(type power)
- (7) electric log NO
(yes or no)

(organization running log)

(8) how well bottom plugged steel plate

RECEIVED

OCT 31 1986


Department of Natural Resources
Bureau of Land & Water Resources

DRILLERS REMARKS:

86294 CMC-02

If well telescopes please sketch and show depths.

GROUND LEVEL

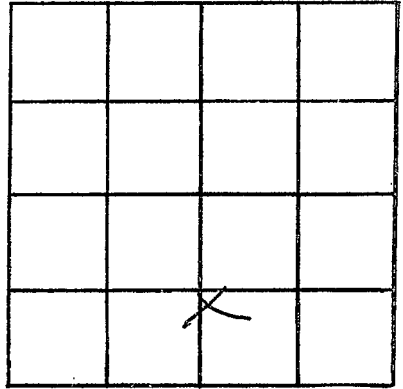

SECTION 20

Please indicate well location X.

ADDITIONAL INFORMATION

If more than one screen,
show locations of each on sketch.