

**CODED**

FLOG # 20

Quitman

B5

8-9-71

MISSISSIPPI  
BOARD OF WATER COMMISSIONERS  
416 North State Street  
Jackson, Mississippi 39201

**CODED**

WATER WELL DRILLERS LOG

8-9

1971

Five Counties Farmers Quitman

date well completed

firm name

county well located

LANDOWNER:

James O. Jackson

(mailing address)

WELL LOCATION:

sec 27 T 29 N R 1 E  
S W  
3/4 miles West of Carling  
(distance) (direction) (nearest town)

WELL PURPOSE: Home  
(home, irrigation, municipal, industrial)

WELL COMPLETION DATA:

- (1) diameter (inches) 4 x 2 1/2
- (2) total depth (feet) 1,608
- (3) static water level (feet) 15 below top of ground. (above)
- (4) casing gal pipe 15.78  
(material) (depth)  
4 x 2 1/2 if telescope see back.  
(size)
- (5) screen 30, 15.78  
(length) (depth to top)  
2 1/2, Stainless Steel  
(size) (material)
- (6) pump 2 HP 3,000 G.P.H  
(HP) (yield gpm)  
Elect.  
(type power)
- (7) electric log Yes  
(yes or no)  
U.S. Geological  
(organization running log) Survey
- (8) how well bottom plugged Backfill  
Value

description of formations encountered

from

to



Clay + Sand		
Sand		42
Clay	42	84
Clay + Sand	84	105
Sand	105	189
Sand + Clay	189	210
Clay	210	420
Clay + Sand	420	441
Sand	441	609
Clay	609	630
Clay	630	693
Clay	693	714
Clay + Rock	714	756
Clay	756	798
Clay + Rock	798	861
Clay	861	882
Clay Sand	882	903
Clay Sand	903	1029
Sand	1029	1071
Sand Clay	1071	1113
Sand Clay	1113	1134
Clay	1134	1197
Clay	1197	1269
Sand + Clay	1269	1310
Sand	1310	1461
Sand	1461	1482
Sand + Clay	1482	1503
Sand + Clay	1503	1523
Sand + Shell	1523	1544
Sand + Shell	1544	1565
Sand + Clay	1565	1586
Sand + Clay	1586	1608
Sand	1608	1629
Sand + Clay	1629	1650

DRILLERS REMARKS:

AUG 24 1971

MISS. BD. OF WATER COMM.

If well telescopes please sketch and show depths.

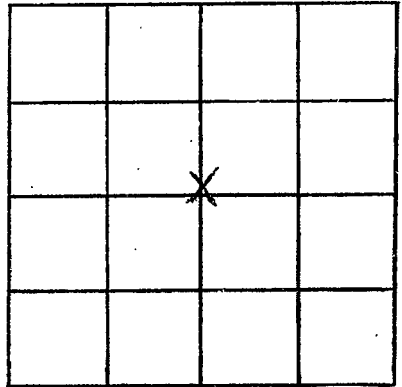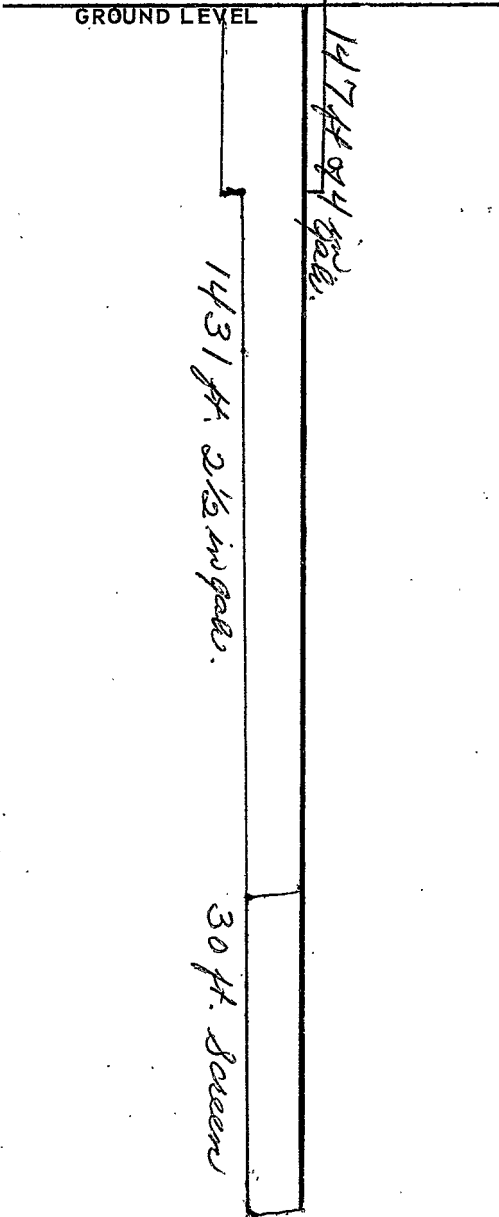

SECTION \_\_\_\_\_

Please indicate well location X.

ADDITIONAL INFORMATION

---

---

If more than one screen, show locations of each on sketch.