

QUITMAN  
B10  
6-16-72

MISSISSIPPI  
BOARD OF WATER COMMISSIONERS  
416 North State Street  
Jackson, Mississippi 39201  
Oran Harper  
WATER WELL DRILLERS LOG

**CODED**

6-16 1972 ROSEY MOUND - date well completed  
firm name  
QUITMAN county well located

LANDOWNER: SELF CO  
MARK S. MILES  
38646  
(mailing address)

description of formations encountered	from	to
	Clay	0
fine sand	15	60
course sand		
gravel	60	118

WELL LOCATION:  
sec. 33 T. 29 N R. 1 E  
7 miles N of MARKS  
(distance) (direction) (nearest town)

WELL PURPOSE: Dr.  
(home, irrigation, municipal, industrial)

**CODED**

- WELL COMPLETION DATA:
- (1) diameter (inches) 20"
  - (2) total depth (feet) 118
  - (3) static water level (feet) 15 below above top of ground.
  - (4) casing 3/4" x 12" 78'0"  
(material) (depth)
  - If telescope see back.  
(size)
  - (5) screen 40'           
(length) (depth to top)
  - 12 3/16" steel  
(size) (material)
  - (6) pump 60 2000  
(HP) (yield gpm)
  - unit  
(type power)
  - (7) electric log no.  
(yes or no)
  - (organization running log)
  - (8) how well bottom plugged steel plate


JUL 13 1972

DRILLERS REMARKS:

FAUCON  
WATER COMM

If well telescopes please sketch and show depths.

GROUND LEVEL

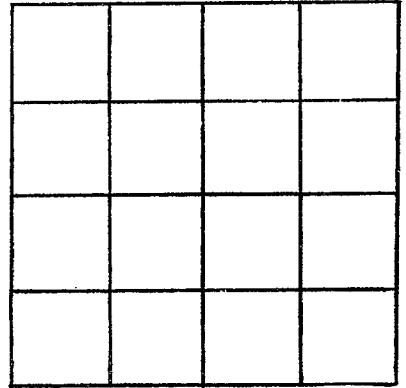

SECTION \_\_\_\_\_

Please indicate well location X.

ADDITIONAL INFORMATION

If more than one screen,  
show locations of each on sketch.