

QUITMAN
BII
6-12-72

MISSISSIPPI
BOARD OF WATER COMMISSIONERS
416 North State Street
Jackson, Mississippi 39201
WATER WELL DRILLERS LOG

CODED

Alan Harper

QUITMAN

6-12 date well completed 1972 POSEY MOUND firm name county well located

LANDOWNER: SELF + CO.
MARKS, MISS
38646
(mailing address)

description of formations encountered	from	to
<u>Clay</u>	<u>0</u>	<u>15'</u>
<u>fine sand</u>	<u>15'</u>	<u>65'</u>
<u>course sand</u>		
<u>gravel</u>	<u>65'</u>	<u>110'</u>

WELL LOCATION:
sec. 35 T. 29 N R. 1 E
7 miles N of MARKS
(distance) (direction) (nearest town)

WELL PURPOSE: Irrigation
(home, irrigation, municipal, industrial)

- WELL COMPLETION DATA:
- (1) diameter (inches) 20"
 - (2) total depth (feet) 110
 - (3) static water level (feet) 15 below ~~above~~ top of ground.
 - (4) casing 10 x 3/4, 82'-0
(material) (depth)
 if telescope see back.
(size)
 - (5) screen 28'-0",
(length) (depth to top)
10", 3/16 steel
(size) (material)
 - (6) pump 30 1200
(HP) (yield gpm)
unit
(type power)
 - (7) electric log no.
(yes or no)

(organization running log)
 - (8) how well bottom plugged steel plate

CODED


JUL 13 1972

DRILLERS REMARKS: _____

MISS. DD. 61
WATER COM. 50111

If well telescopes please sketch and show depths.

GROUND LEVEL

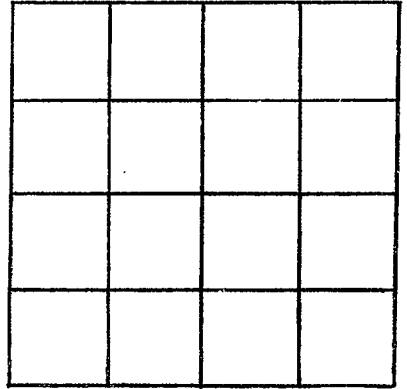

SECTION _____

Please indicate well location X.

ADDITIONAL INFORMATION

If more than one screen,
show locations of each on sketch.