

QUITMAN MISSISSIPPI BOARD OF WATER COMMISSIONERS

CODED

B 12
10-9-65

WATER WELL DRILLERS LOG

Date: Oct. 9, 1965, Driller: Robert E. Rathliff County Quitman
(Name)

(1) Owner of Land: Mr. Guy Henry
(Name)
Darling, Miss.
(Address)

(2) Location: 1/4, 1/4, Sec. 32 29 10
6 miles west of Darling
(distance) (direction) (Nearest Town)

(3) Topography: Flat
(Hilly) (Flat) (Level)

(4) Purpose of Well: Domestic
(Domestic Irrigation
Municipal, Industrial, Other)

Description & Color of Materials Sand, Clay, Red Clay, Shell, etc.	Thick- ness Feet	Depth Feet
<u>Top soil</u>	<u>66</u>	<u>66</u>
<u>sand</u>	<u>62</u>	<u>128</u>
<u>Gravel</u>	<u>24</u>	<u>152</u>
<u>sand</u>	<u>89</u>	<u>241</u>
<u>sand & clay</u>	<u>56</u>	<u>297</u>
<u>sand, gravel</u>	<u>195</u>	<u>492</u>
<u>rock</u>	<u>1</u>	<u>493</u>
<u>shale & sand</u>	<u>293</u>	<u>786</u>
<u>sand</u>	<u>63</u>	<u>849</u>
<u>shale</u>	<u>3</u>	<u>852</u>

Information upon completion of well:

(1) Diameter 2 inches.

(2) Total Depth 849 feet.

(3) Water Level 5' above feet below top of ground.

(4) Cased to 829, Size 2

(5) Screen: Size _____, Length _____

(6) Were any formations sealed against pollution?
_____ yes, no.


Handwritten signature

CODED

If YES depth of formation _____

Why _____

Drillers Remarks: _____

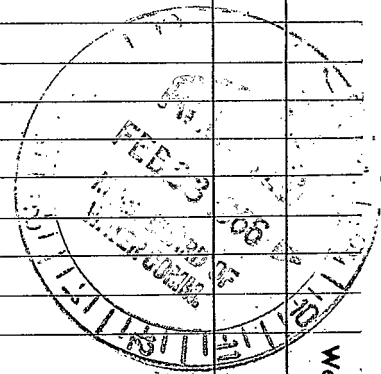

(Use Back Side)

Well No.

