

CODED

MISSISSIPPI
BOARD OF WATER COMMISSIONERS
416 North State Street
Jackson, Mississippi 39201

WATER WELL DRILLERS LOG

Quitman
B 13
5-67

5-8 ' 1967 Widener Farmers Assn Quitman
date well completed firm name county well located

LANDOWNER: John Ford

description of formations encountered

from

to

Essex Miss

Top Soil Clay
Fine Sand
Med Sand
Coarse Sand +
Gravel
Clay + White Sand

14
14 40
40 46 1/2
46 1/2 116
116 125

(mailing address)

WELL LOCATION:


sec 28 T. 29 N R. 10 E
1/4 miles W of Darling
(distance) (direction) (nearest town)

WELL PURPOSE: Irrigation
(home, irrigation, municipal, industrial)

CODED

WELL COMPLETION DATA:

- (1) diameter (inches) 6
- (2) total depth (feet) 118
- (3) static water level (feet) 10 below above top of ground.
- (4) casing 6" Pipe 70
(material) (depth)
- 6 if telescope see back.
(size)
- (5) screen 48 70
(length) (depth to top)
- 6 Drain
(size) (material)
- (6) pump 30 1000
(HP) (yield gpm)
- Inverter
(type power)
- (7) electric log no
(yes or no)

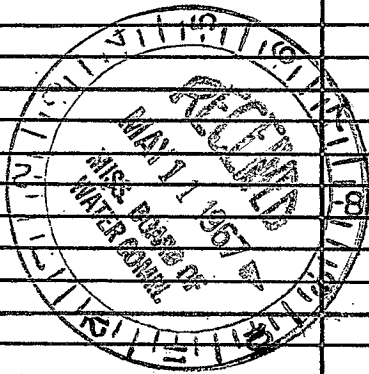

(organization running log)


(8) how well bottom plugged Welded

DRILLERS REMARKS:

[Handwritten signature]

If well telescopes please sketch and show depths.

GROUND LEVEL

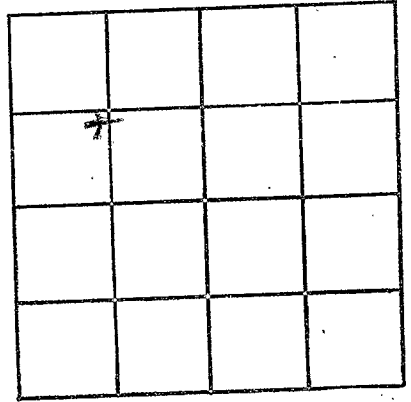

SECTION 28

Please indicate well location X.

ADDITIONAL INFORMATION

Lined area for additional information.

If more than one screen, show locations of each on sketch.