

Quitman
B18
4-13-81

MISSISSIPPI
BOARD OF WATER COMMISSIONERS
416 North State Street
Jackson, Mississippi 39201

CODED

Quitman

WATER WELL DRILLERS LOG

4-13-81 date well completed
Hester Mullig firm name
Quitman county well located

LANDOWNER:	description of formations encountered	from	to
Murray Stone Rich, Miss	Clay & gravel Fine sand Coarse sand & gravel	0	38 38 60 60/03
(mailing address)			
WELL LOCATION: sec. 3 T. 9 N. R. 2 E 7/16 miles East of Rich (distance) (direction) (nearest town)			
WELL PURPOSE: (home, irrigation, municipal, industrial)			
WELL COMPLETION DATA:			
(1) diameter (inches) 16 in			
(2) total depth (feet) 102			
(3) static water level (feet) 8 below top of ground			
(4) casing Steel 63 (material) (depth)			
no (size) if telescope see back.			
(5) screen 40 63 (length) (depth to top)			
16 Steel (size) (material)			
(6) pump 60 5000 (HP) (yield gpm)			
Proposed (type power)			
(7) electric log no (yes or no)			
no (organization running log)			
(8) how well bottom plugged Steel plate			
DRILLERS REMARKS: Shippy Norman & well in hand			

CODED


DEPT. OF NATURAL RESOURCES
BUREAU OF LAND & WATER RESOURCES

MAY 7 1981

RECEIVED

If well telescopes please sketch and show depths.

GROUND LEVEL

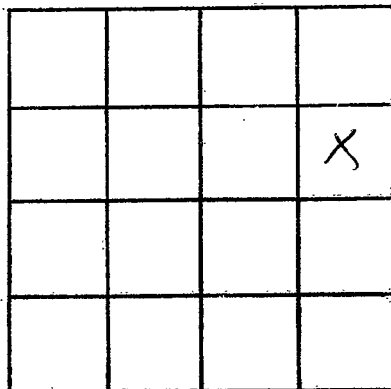

SECTION _____

Please indicate well location X.

ADDITIONAL INFORMATION

If more than one screen,
show locations of each on sketch.