

Quitman  
B 19  
4-10-81

MISSISSIPPI  
BOARD OF WATER COMMISSIONERS  
416 North State Street  
Jackson, Mississippi 39201

CODED

Quitman

WATER WELL DRILLERS LOG

4-10-1981 date well completed  
Hester Drilling firm name  
Quitman county well located

LANDOWNER: Crenshaw Bros  
Crenshaw, Miss  
(mailing address)

description of formations encountered	from	to
Clay & Gravel	0	40
Gravel sand	40	58
Coarse sand & gravel	58	103

WELL LOCATION:  
sec. 35 T. 29 N. R. 10 E  
7 1/2 miles SW of Sledge  
(distance) (direction) (nearest town)

WELL PURPOSE: Drinking  
(home, irrigation, municipal, industrial)


- WELL COMPLETION DATA:
- (1) diameter (inches) 16
  - (2) total depth (feet) 103
  - (3) static water level (feet) 12 below top of ground
  - (4) casing Steel 63  
(material) (depth)
  - no if telescope see back.  
(size)
  - (5) screen 40 63  
(length) (depth to top)
  - 16 Steel  
(size) (material)
  - (6) pump 50 3000  
(HP) (yield gpm)
  - Electric  
(type power)
  - (7) electric log no  
(yes or no)
  - no  
(organization running log)
  - (8) how well bottom plugged Steel plate

DRILLERS REMARKS:  
Good formation

DEPT. OF NATURAL RESOURCES  
BUREAU OF LAND & WATER RESOURCES  
MAY - 7 1981  
RECEIVED

If well telescopes please sketch and show depths.

GROUND LEVEL

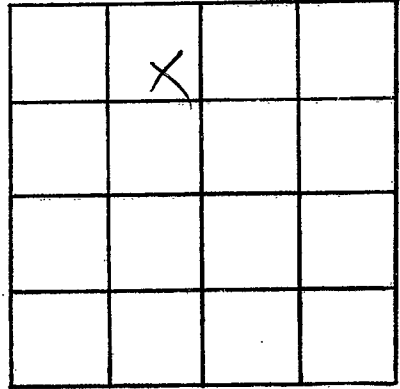

SECTION \_\_\_\_\_

Please indicate well location X.

ADDITIONAL INFORMATION

If more than one screen, show locations of each on sketch.