

Job # 9493

State Well Report
Part 1 - Driller's Log

Mississippi Department of Environmental Quality
Office of Land and Water Resources
P.O. Box 2309
Jackson, MS 39225
(601)961-5210
(601)961-5228 (fax)

County: Quitman
Permit #: GW43764
Driller: Pete Saffigton
Date drilling completed: 11-19-09

For Office Use Only:
Aquifer: B 43
Well #: _____
L. S. Elevation: _____
E-log #: _____

State Law requires that this report be prepared by the license holder responsible for the work and filed with the Department at the above address within 30 days of completion of drilling of the well or borehole.

<p>Information on Well Owner (Landowner if borehole is not for a water well)</p> <p>Owner Name: <u>Charlotte McPheeters</u></p> <p>Mailing Address: <u>1255 N. Basin Lake</u></p> <p><u>Sarasota Fla. 34242</u> City State Zip Code</p> <p>Telephone No. <u>(813) 444-8531</u></p>	<p>Well or Borehole Location</p> <p>Latitude: <u>34° 21' 40"</u> Longitude: <u>90° 19' 28"</u></p> <p>Method of Lat/Long (circle one): Conventional Survey, <u>24</u> <u>59</u></p> <p>USGS quad, <u>(Hand-held GPS)</u> Survey-grade GPS</p> <p><u>SE 1/4 NE</u> Sec <u>30</u> / Twn <u>29N</u> Rng <u>1W</u></p> <p>Distance <u>3.5</u> Miles Direction <u>W</u> of Nearest Town <u>Darling, Ms</u></p>
---	--

Well / Borehole Data

Date drilling started: 11-19 Date drilling completed: 11-19 Hole depth: 100' Hole diameter: 28"

Location of the source of any surface water used for drilling: Ditch 1/4 mile west

Method of dosing and volume of Chlorine used in drilling and development: Sodium Hypo Chlorite @ 10ppm

Logs run (circle all applicable): No log run Electric Gamma Ray Density Sonic Neutron Other: _____

Name of organization running log(s): _____

Purpose of borehole (check one): Water Well Geotechnical/Geological Investigation _____ Ground Source Heat Pump _____

Seismic Survey _____ Other (describe) _____

If drilling is not related to water well construction, skip the remainder of this block

Purpose of Well (check one): Home _____ Industrial _____ Public Supply _____ Irrigation Fish Culture _____ Other: _____

If a flowing well, method of flow regulation: Valve _____ Other (describe) _____

Static Water Level: 15' feet above or below (circle one) land surface Date measured: 11-19-09

Method of Measurement (circle one): steel tape electric tape air line other: _____

Well depth: 100' Well grouted to a depth of 10 feet Type of grout (circle one): Neat Cement Bentonite Mix

Casing length: 60 feet Casing diameter: 16 inches Type of casing: Sch 40 PVC

Screen length: 40 feet Screen diameter: 16 inches Type of screen: Sch 40 PVC

Screen slot size: .032 inches Setting depth: From 60 feet to 100 feet

Type of completion (circle all applicable): Gravel packed Underreamed Telescoped Open hole Natural Development

Other (describe): _____

Top of lap pipe or reduction in casing: _____ feet. *If telescoped or more than one screen, describe on next page*

Form: OLWR-SWR-1A (04/08)

RECEIVED
FEB 03 2010
BY: OLWR

B43

The sketch below only required for water wells

If well telescopes, show depths on sketch.

Ground Level $\xrightarrow{\quad}$

Description of formations encountered must be provided for all wells and boreholes, unless specifically exempted by regulations

Description of Formations Encountered	From (depth)	To (depth)
	Ground Level	
Clay	0	25
Fine Sand & Clay	25	35
Coarse Sand & Gravel	35	100

If more than one screen, show location of each on sketch

Sketch the property layout and include the following: 1) the well location; 2) any permanent structures on the property that may aid in locating the well; 3) any roads, power lines, or other items that may aid in locating the property and the well; 4) a north arrow.

Landowner Name: Charlotte McPheeters

Form: OLWR-SWR-1A (04/08)

I certify that the well/borehole was drilled, constructed, and completed in accordance with all applicable requirements of the Mississippi Department of Environmental Quality and the Mississippi Department of Health regulations, if applicable, and state laws.

0430
 Print Name of Responsible Licensee and License No.
PETE SAPPINGTON

12-1409
 Date

[Signature]
 Signature of Licensee

RECEIVED
FEB 03 2010
BY: OLWR

STATE WELL REPORT

Part 2

Pump Installer's Completion Report
 Mississippi Department of Environmental Quality
 Office of Land and Water Resources
 P.O. Box 10631
 Jackson, MS 39289-0631
 (601)961-5210
 (601)354-6938 (fax)

For Office Use Only:

Aquifer: B43
 Well #: _____
 Elevation: _____

County: Quitman
 Permit #: GDWA3764
 Driller: PETE SAPPENGTON
 Date completed: 11-19-09
Copy information from block on Part 1

This part of the report must be completed by a licensed water well contractor or a licensed pump installer. A copy of Part 1 of the report must be attached and both parts filed with the Department at the above address within 30 days of well completion.

Well Owner Information	Well Location
Owner Name: <u>Charlotte McPheeters</u>	Latitude: <u>34°21'21.8" N</u> Longitude: <u>90°20'02.6" W</u>
Mailing Address: <u>1255 N. BASEN LAKE</u>	Method of Lat/Long (check one): Conventional Survey _____ USGS quad _____, Hand-held GPS _____, Survey-grade GPS _____
<u>Sarasota</u> <u>FL</u> <u>34242</u> City State Zip Code	<u>1/4</u> <u>1/4</u> Sec <u>30</u> T <u>29N</u> R <u>1W</u>
Telephone No. <u>(813) 444-8531</u>	Distance Direction Nearest Town <u>3.1</u> Miles <u>N</u> of <u>DARLING, MS</u>

Pump Type Circle one	Power Type Circle one
Air Lift: Jet <input type="checkbox"/> Submersible <input type="checkbox"/>	<u>Diesel Engine</u> Gasoline Engine Natural Gas
Bucket: Piston <input type="checkbox"/> <u>Turbine</u> <input checked="" type="checkbox"/>	Electric Motor Hand Tractor PTO
Centrifugal: Rotary <input type="checkbox"/> Flowing Well <input type="checkbox"/>	Windmill Other (specify): _____
Other (specify): _____	Horse Power Rating of Motor: <u>80</u>
Date Pump Installed: <u>1-12-2010</u>	Setting Depth: <u>70</u> feet
Rated Pump Capacity: <u>3000</u> Gallons Per Minute	Number of Stages: <u>1</u>

Pump Test Data	Method of Measuring Water Level Circle one
Date Well Tested: _____	Air Line Electric Measuring Line <u>Steel Tape</u> <input checked="" type="checkbox"/>
Static Water Level (A): <u>15</u> Feet Below Land Surface	Other (specify): _____
Pumping Water Level (B): _____ Feet Below Land Surface	For flowing well, measured shut in head: _____ feet
Drawdown [(B) - (A)]: _____ Feet Below Land Surface	Well yielded _____ GPM with a drawdown of _____
Test Pumping Rate: _____ Gallons Per Minute	_____ feet after _____ hours of pumping
Duration of Pump Test (minimum 4 hours): _____ hours	

I HEREBY CERTIFY that the above statements are true to the best of my knowledge.

David P. Holt 0-752P
 Print Name of Pump Installer and License No. (if applicable)


[Signature]
 Signature of Pump Installer

Form: OLWR-SWR-1B
RECEIVED

FEB 03 2010

BY: OLWR

J013
9493

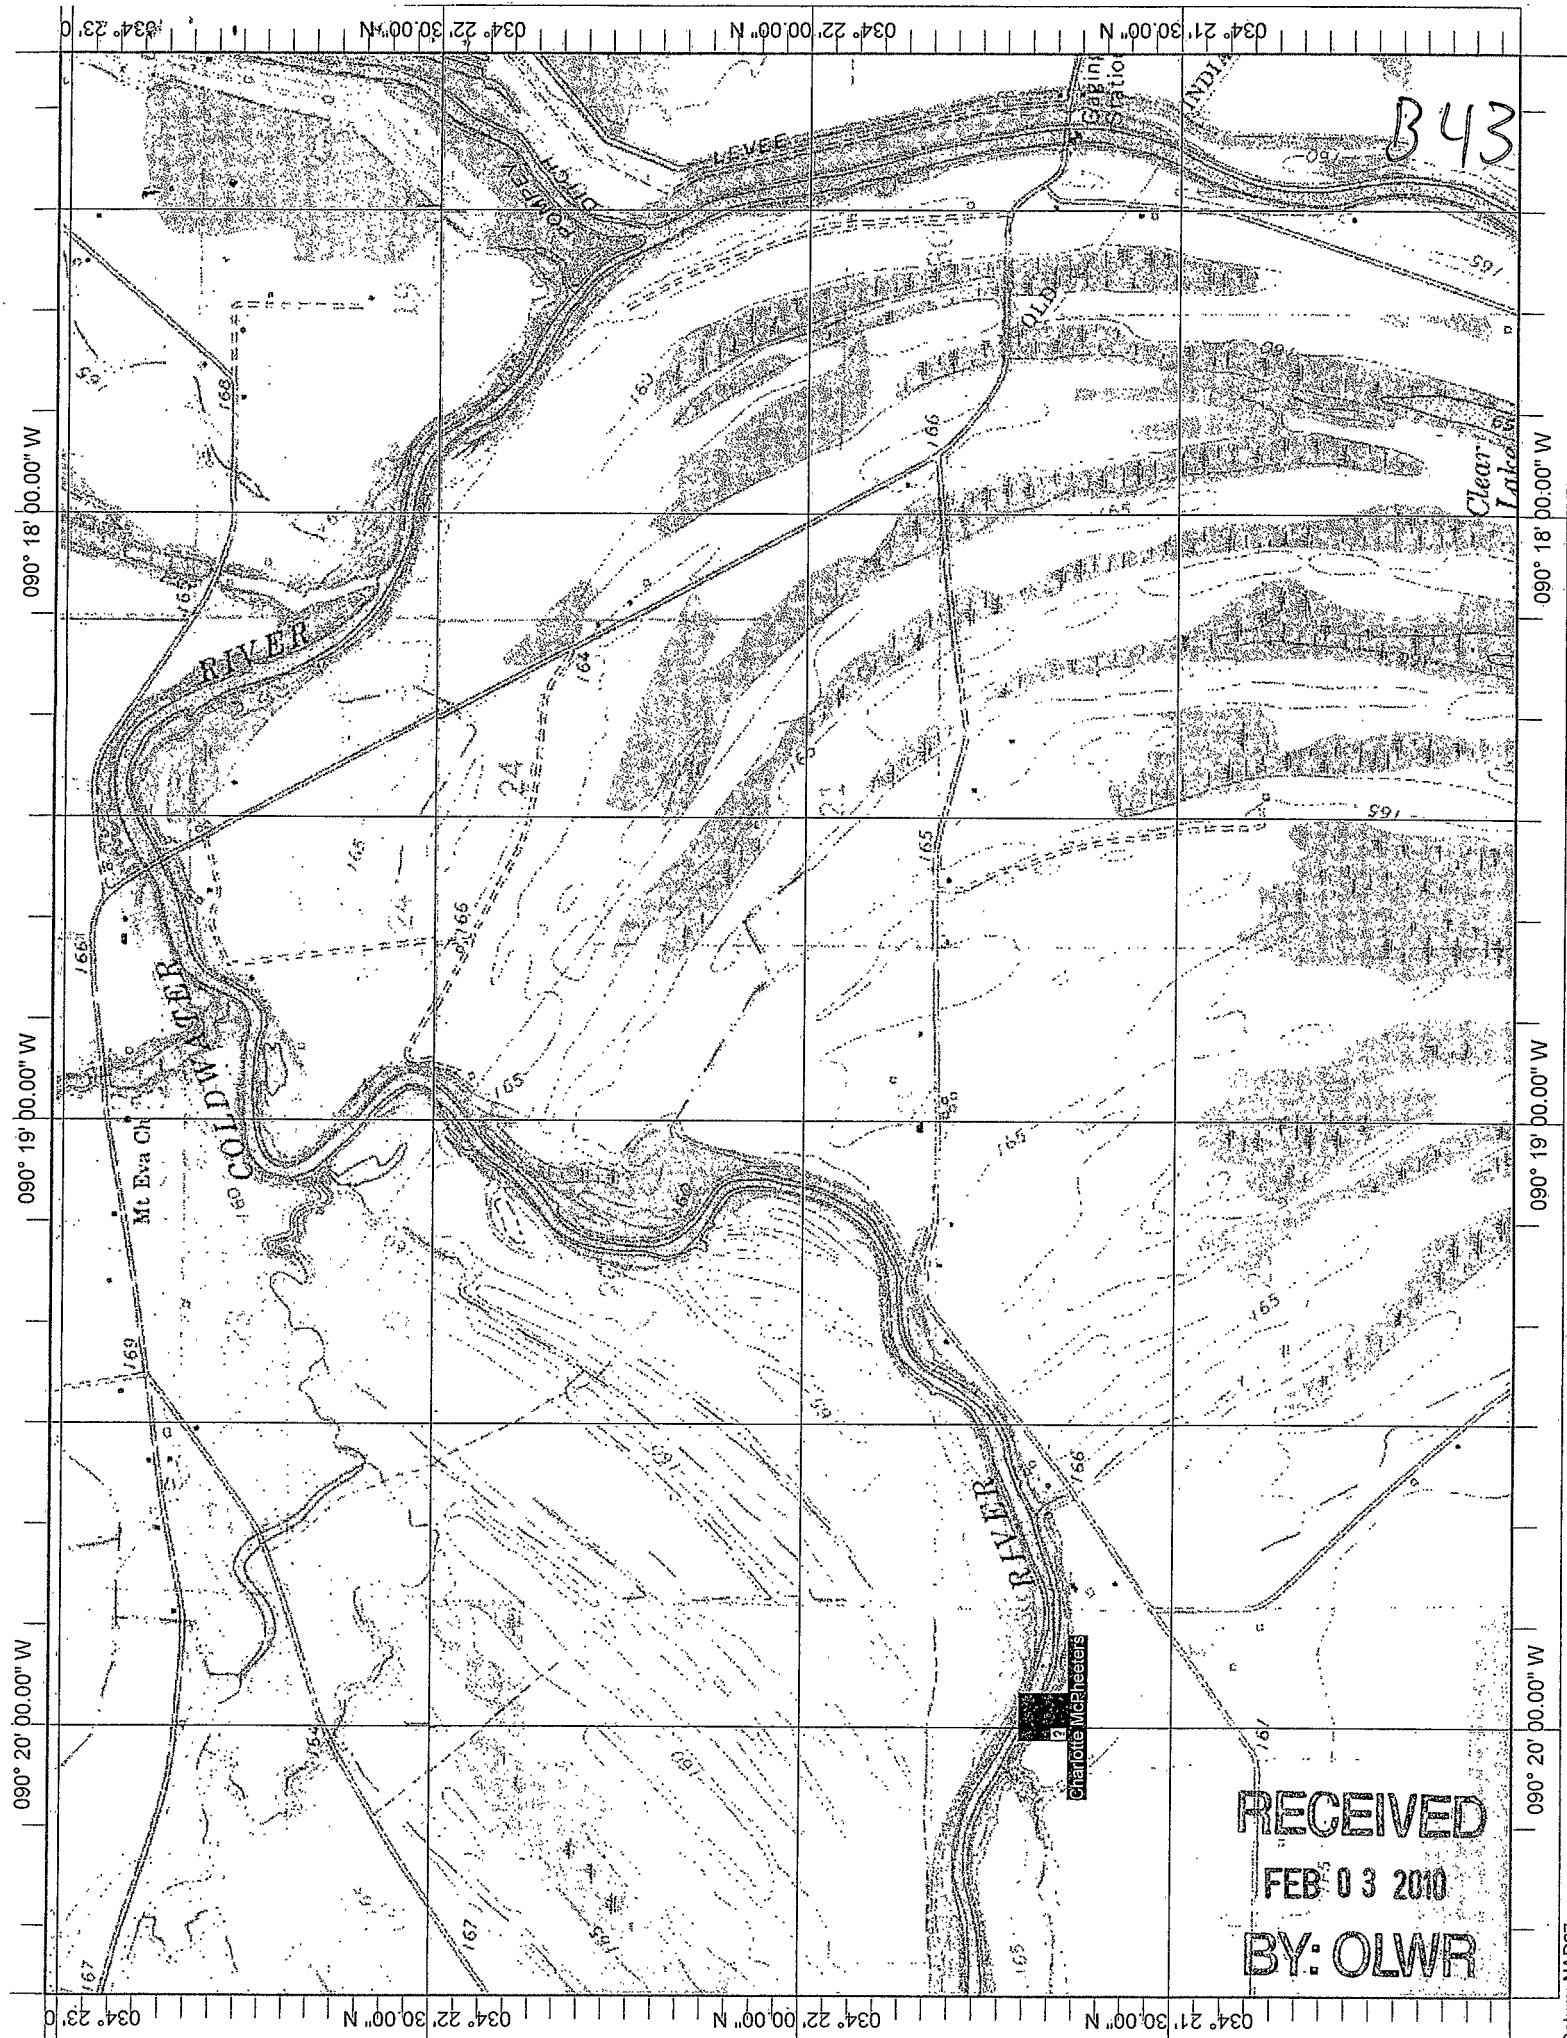

RECEIVED
FEB 03 2010
BY: OLWR