

MISSISSIPPI BOARD OF WATER COMMISSIONERS

QUITMAN

B 2000

2-27-61

WATER WELL DRILLERS LOG

Date: FEB 27, 1961, Driller: DELTA DRILLING CO. County LEFLORE

(Name)

(1) Owner of Land: M. G. MEARTHUR
(Name)RTE. 1, SLEDGE, MISS.
(Address)(2) Location: 1/4, 1/4, Sec 29, T 21 N, R 10 W miles , of
(distance) (direction) (Nearest Town)(3) Topography: (Hilly) (Flat) (Level)(4) Purpose of Well: DOMESTIC
(Domestic Irrigation
Municipal, Industrial, Other)


Information upon completion of well:

(1) Diameter 3 inches.(2) Total Depth 993 feet.(3) Water Level WELL FLOWS feet below top of ground.(4) Cased to 993', Size 2" 485'(5) Screen: Size 2, Length 30
2X3" LEAD SEAL

(6) Were any formations sealed against pollution?

 yes, ✓ no.If YES depth of formation Why Drillers Remarks: 20' LAP OF 2" IN 3"PIPE - WELL FLOWS 10 GPM

Description & Color of Materials Sand, Clay, Red Clay, Shell, etc.	Thick- ness Feet	Depth Feet
GUMBO	17	17
SAND	111	128
GRAVEL	63	191
GUMBO	20	211
SAND	37	248
SHELL	36	284
GUMBO	83	367
SAND	84	451
GUMBO	79	530
SHELL	107	637
GUMBO	23	660
SAND	21	681
GUMBO	24	705
SAND	16	721
GUMBO	20	741
FINE GREY SAND	50	791
SHELL	34	825
GUMBO	55	880
SHELL	50	930
GUMBO	22	952
WHITE SAND	41	993

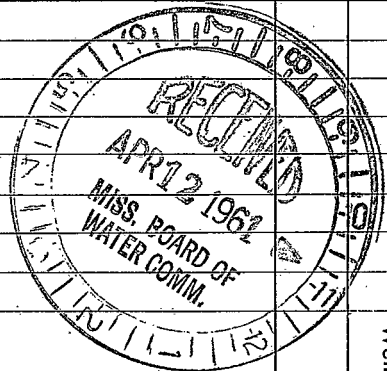

(Use Back Side)

Well No.

