

Ortman
B 2001
7-23-76

MISSISSIPPI
 BOARD OF WATER COMMISSIONERS
 416 North State Street
 Jackson, Mississippi 39201

WATER WELL DRILLERS LOG

July 23 1976 J.B. Cain Ortman
 date well completed firm name county well located

LANDOWNER Mr. Tracy
Dorling Mess
 (mailing address)

WELL LOCATION:
 sec. 32 T 29 N ✓ R 11 E ✓
 S W
6 miles N-W of Marks
 (distance) (direction) (nearest town)

WELL PURPOSE: HOMEP
 (home, irrigation, municipal, industrial)

WELL COMPLETION DATA:

(1) diameter (inches) 4 X 2
 (2) total depth (feet) 1415-978
 (3) static water level (feet) flow below above top of ground.
 (4) casing Steel 1415
 (material) (depth)
 (size) If telescope see back.
 (5) screen 40 1480
 (length) (depth to top)
2" Steel
 (size) (material)
 (6) pump 3/4 10
 (HP) (yield gpm)
Elect
 (type power)
 (7) electric log NO
 (yes or no)
 (organization running log)
 (8) how well bottom plugged Plug

description of formations encountered	from	to
Clumbo	0	38
Sand	38	65
Sand Gravel	65	150
Clay & L.g. line	12	295
Rock	295	301
Clay	201	325
Rock	285	275
Clay	386	410
Sand	410	460
Clay	460	523
Sand	563	570
Clay	570	580
Sand	580	591
Sand & Clay st	594	699
Sand	699	697
Clay	697	705
Sand	705	760
Clay	760	810
Sand	810	970
Clay	970	1028
Rock	1028	1030
Clay	1030	1069
Rock	1063	1067
Sand	1067	1078
Clay	1078	1129
Sand & Clay	1129	1200
Rock	1200	1200
Blue shale	1200	1230
Rock	1250	1251
Blue shale	1251	1293
Sand & Clay	1293	1343
Sand Gravel	1343	1363
Sand	1363	1415


RECEIVED

AUG 12 1976

DRILLERS REMARKS:

If well telescopes please
sketch and show depths.

GROUND LEVEL

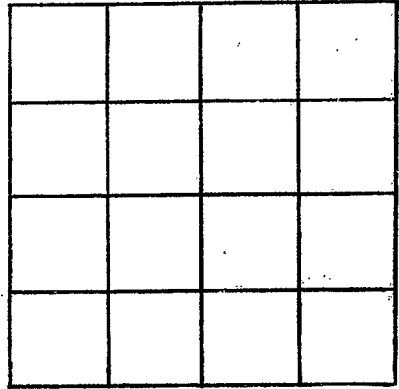

SECTION _____

Please indicate well location X.

ADDITIONAL INFORMATION

If more than one screen,
show locations of each on sketch.