

QUITMAN
 B 2002
 12-20-79

MISSISSIPPI
 BOARD OF WATER COMMISSIONERS
 416 North State Street
 Jackson, Mississippi 39201
 WATER WELL DRILLERS LOG

Dec. 20 1978 Bruce Berryman QUITMAN
 date well completed firm name county well located
 Greenwood.

LANDOWNER: H.W. Williams	description of formations encountered	from	to
Rt. 1. Sledge,	Clay	0	20
Miss. 38670	Sand	20	80
(mailing address)	Sand & gravel	80	140
WELL LOCATION:	Clay	140	220
sec. 30 T 29 N R 11 E	Sand	220	340
4 miles E of RICH	Clay	340	420
(distance) (direction) (nearest town)	Sand & Str. clay	420	480
WELL PURPOSE: Home	Sand	480	540
(home, irrigation, municipal, industrial)	Shale & rock	540	560
WELL COMPLETION DATA:	Shale	560	720
(1) diameter (inches) 4" x 2"	Fine sand	720	760
(2) total depth (feet) 966'	Shale	760	790
(3) static water level (feet) FLOW below top of ground.	Sand	790	800
(4) casing 4" blk. 126' 2" galv. 819'	Shale & sand	800	860
(material) (depth)	Brown sand	860	880
(size) If telescope see back.	Sand	880	900
(5) screen 20' 946'	Shale	900	940
(length) (depth to top)	Sand	940	960
2" .010 stainless steel	Shale	960	990
(size) (material)			
(6) pump 1 h.p. 15			
(HP) (yield gpm)			
Electric			
(type power)			
(7) electric log No			
(yes or no)			
(organization running log)			
(8) how well bottom plugged B.P.V			
DRILLERS REMARKS:			


Miss. Board of Water Comm.

MAY - 8 1979

RECEIVED

If well telescopes please sketch and show depths.

GROUND LEVEL

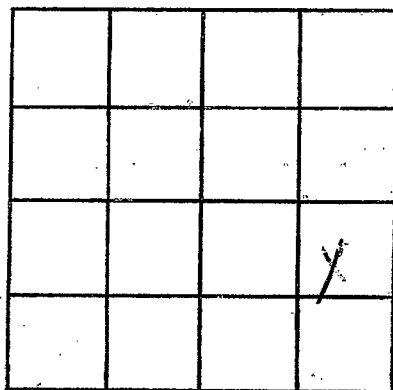

SECTION 30

Please indicate well location X.

ADDITIONAL INFORMATION

If more than one screen, show locations of each on sketch.