

Quitman

C 25

9-66

Elcc. Log

Sept. 1966 19

date well completed

MISSISSIPPI

BOARD OF WATER COMMISSIONERS

416 North State Street

Jackson, Mississippi 39201

CODED

WATER WELL DRILLERS LOG

Robert E. Kattiff

firm name

Quitman

county well located

LANDOWNER: Mr. Perkins

Series - Soft g. Miss.

Darling Miss.

(mailing address)

description of formations encountered

from

to

WELL LOCATION:

sec 28 T 8 N R 10 E in Darling

(distance) (direction) (nearest town)

WELL PURPOSE: industrial (home, irrigation, municipal, industrial)

WELL COMPLETION DATA:

- (1) diameter (inches) 4x3
(2) total depth (feet) 1483
(3) static water level (feet) 1423 below top of ground
(4) casing Steel 4x3 (material) (depth)
(5) screen 40' 1423 (length) (depth to top)
(6) pump Flowing 70 gpm (HP) (yield gpm)
(7) electric log yes (organization running log)
(8) how well bottom plugged open


Table with 3 columns: description of formations encountered, from, to. Rows include: Lumber, Sand & gravel, Gumbo, Sand, Gumbo, Sand, Clay w/ sand streaks, Shale & Gumbo, Sand, Gumbo, Rock, Gumbo, Clay-sandy, Gumbo, Rock, sand shale, Gumbo, Sand, Gumbo.

CODED



DRILLERS REMARKS:

If well telescopes please sketch and show depths.

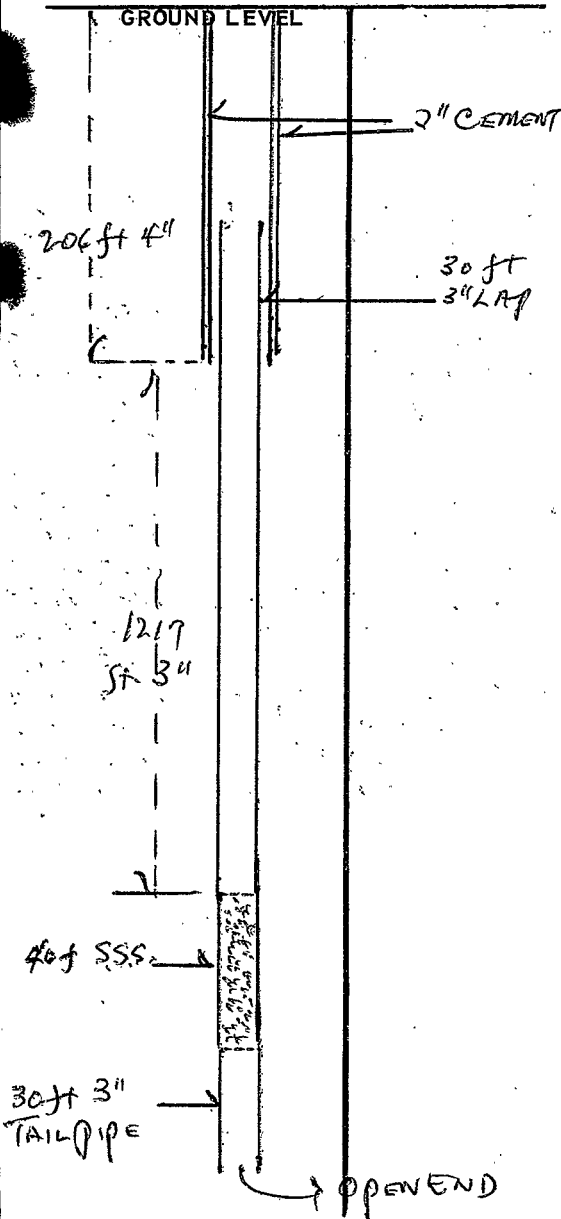

X			

SECTION 28

Please indicate well location X.

ADDITIONAL INFORMATION

If more than one screen, show locations of each on sketch.