

CODED

C2494

MISSISSIPPI
BOARD OF WATER COMMISSIONERS
416 North State Street
Jackson, Mississippi 39201
MS 6W-12749
WATER WELL DRILLERS LOG

Quitman
C26
10-67
Elec Log

October 10, 1967 Layne-Central Company Quitman
date well completed firm name county well located

LANDOWNER: Darling Water Assn.

description of formations encountered	from	to
Clay	0	18
Fine grey sand	18	40
Coarse sand	40	60
Coarse sand & pea gravel	60	105
Coarse sand & gravel	105	115
Clay	115	118
Sand	118	219
Sand & strks. clay	219	250
Sand	250	284
Clay	284	327
Rock	327	328
Clay	328	370
Sand, strks. sandy shale	370	390
Rock	390	391
Shale	391	393
Rock	393	396
Shale	396	400
Rock	400	402
Shale	402	407
Rock	407	408
Shale	408	415
Rock	415	419
Shale	419	463
Sand	463	476
Shale	476	576
Sand	576	601
Sand, strks. shale	601	632
Sand	632	699
Sand, strks. shale	699	725
Sand	725	749
Sand, strks. shale	749	775
Sand	775	797
Shale	797	869
Sand	869	901
Shale	901	955
Rock	955	956

Darling, Mississippi
(mailing address)

WELL LOCATION:
sec. 29 T. 80 N R. 10 E
5 miles of Darling
(distance) (direction) (nearest town)


WELL PURPOSE: municipal
(home, irrigation, municipal, industrial)

WELL COMPLETION DATA:

- (1) diameter (inches) 8x4
- (2) total depth (feet) 1529' 5"
- (3) static water level (feet) 24' 10" below top of ground.
- (4) casing steel 1473' 5" (material) of (depth) 23' 6" of tap 8x4 (size) if telescope see back. 1473' 5" (material)
- (5) screen 51' (length) 1524' 5" (depth to top) 1/2" Stainless Steel (size) (material)
- (6) pump 15 (HP) 150 (yield gpm) electric (type power)
- (7) electric log yes (yes or no) U.S.G.S. (organization running log)
- (8) how well bottom plugged Slugs and shot.

CODED


DRILLERS REMARKS:

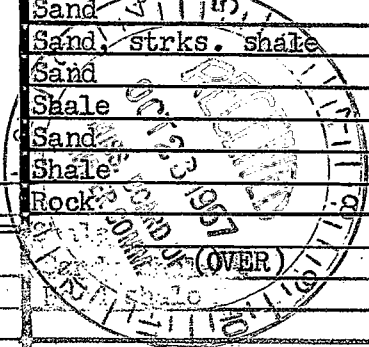

(OVER)

If well telescopes please sketch and show depths.

GROUND LEVEL

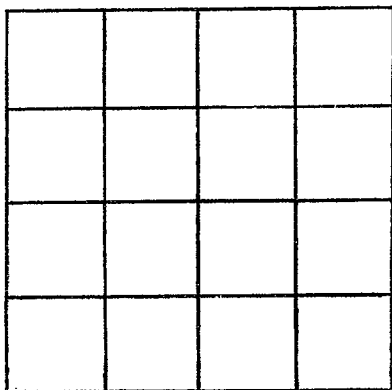

SECTION _____

Please indicate well location X.

ADDITIONAL INFORMATION

Shale	956	1050
Sandy shale	1050	1112
Hard shale	1112	1165
Sandy shale	1165	1227
Shale	1227	1277
Fine sand	1277	1316
Sandy shale	1316	1360
Shale	1360	1412
Fine sand	1412	1523
Shale	1523	1531

If more than one screen, show locations of each on sketch.